


T. 2 S. R. 4 W.

Scale 1" = 660'

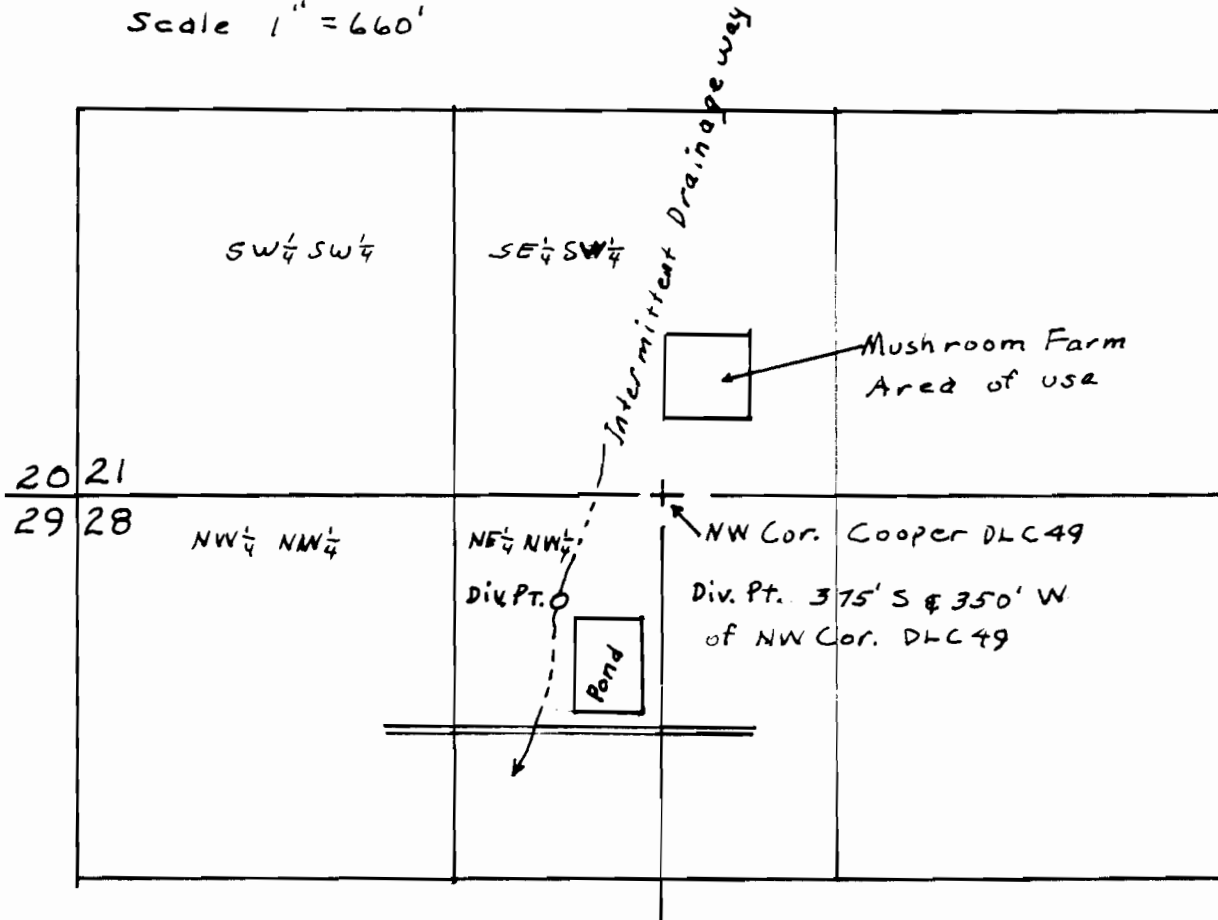

W. M. R. L. S.

This is to identify the location of the water right only and is not intended to provide legal dimensions or locations of property ownership lines

R-69568 * 69569
R10901
50219