

FINAL PROOF SURVEY MAP


IN THE NAME OF JOHN R. GORDON

SECTION 16, T25S, R7W, W.M.

LOTS 14 AND 15, RASMUSSEN HOLE SUBDIVISION



1 INCH = 1320 FEET

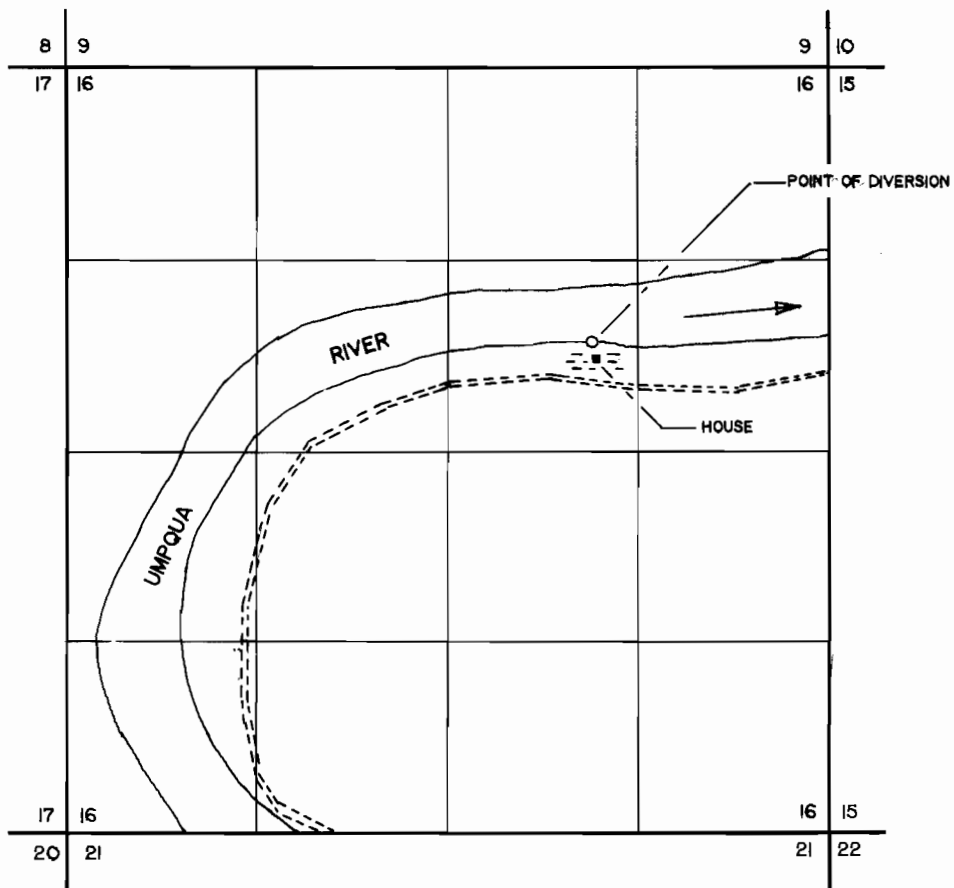

THE POINT OF DIVERSION IS LOCATED 740 FEET NORTH AND 1645 FEET WEST FROM THE EAST 1/4 CORNER OF SECTION 16, BEING WITHIN THE SOUTHWEST 1/4 OF THE NORTHEAST 1/4 OF SECTION 16, TOWNSHIP 25 SOUTH, RANGE 7 WEST, W. M.

THE PURPOSE OF THIS MAP IS TO IDENTIFY THE LOCATION OF THE WATER RIGHT. IT IS NOT INTENDED TO PROVIDE INFORMATION RELATIVE TO THE LOCATION OF PROPERTY OWNERSHIP BOUNDARY LINES.

