


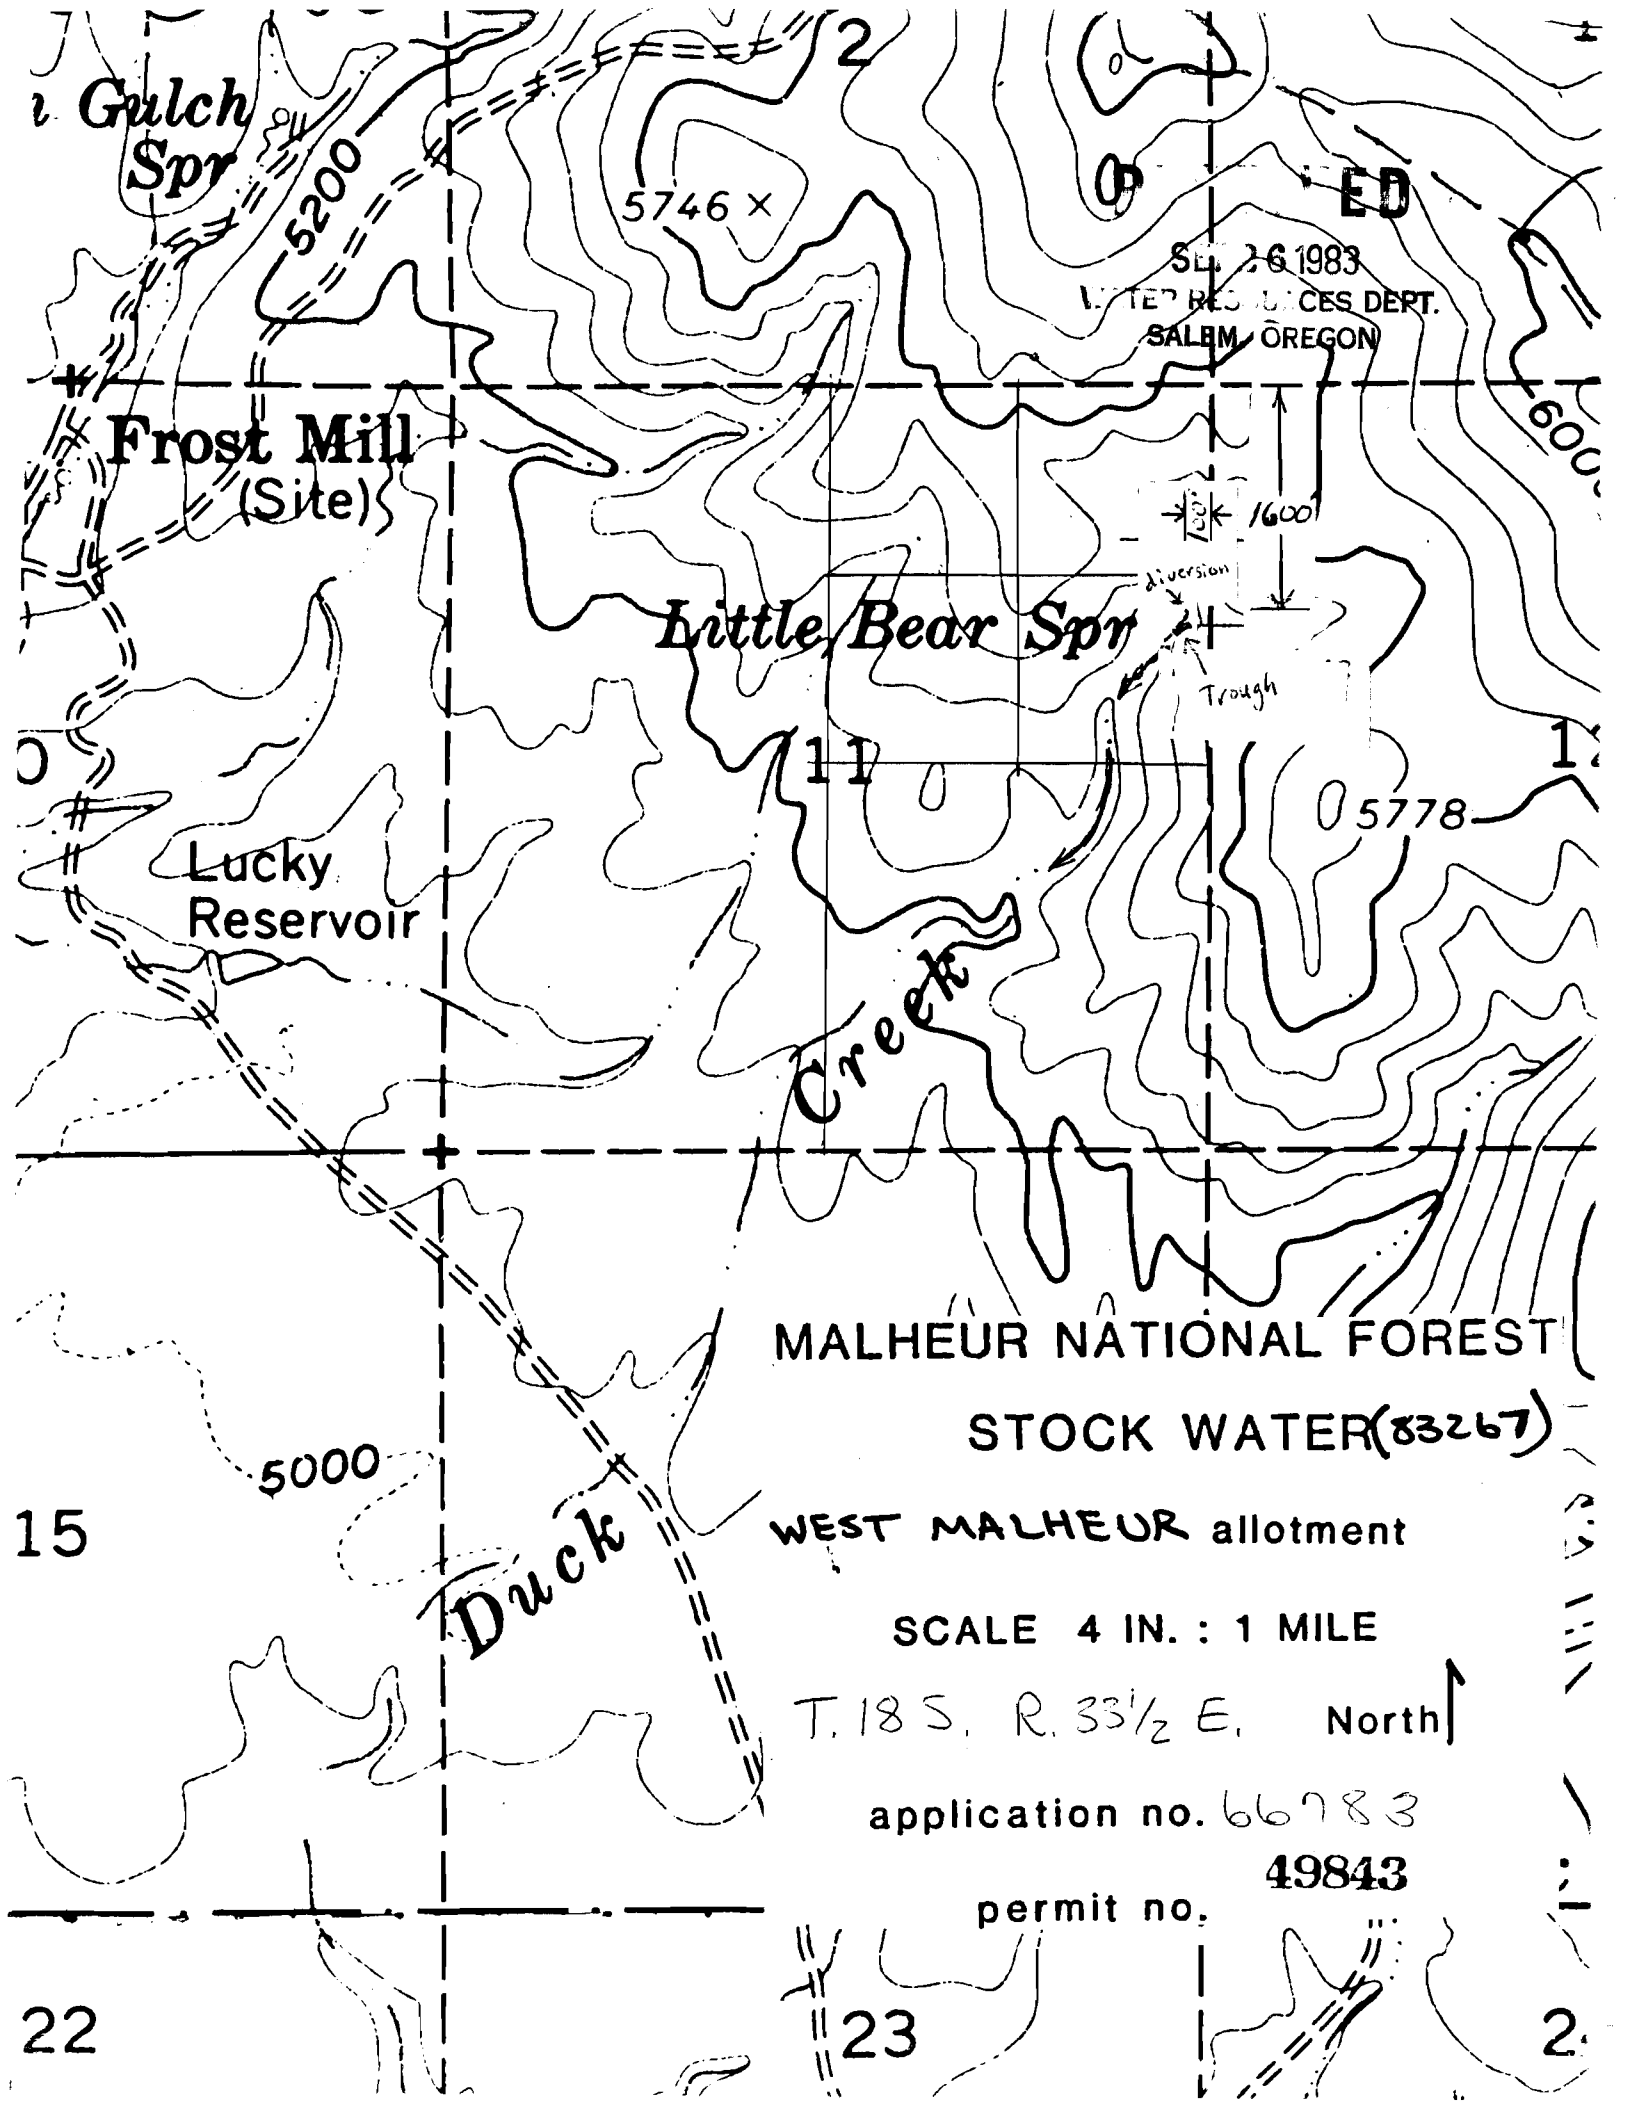

Galch Spr

5746 X

ED

SEP 26 1983
SALM, OREGON

Frost Mill
(Site)

Little Bear Spr

Lucky Reservoir

Creek

MALHEUR NATIONAL FOREST
STOCK WATER (83267)

WEST MALHEUR allotment

SCALE 4 IN. : 1 MILE

T. 18 S., R. 33 1/2 E. North

application no. 66783

permit no. 49843

5000

Duck

22

23

24