


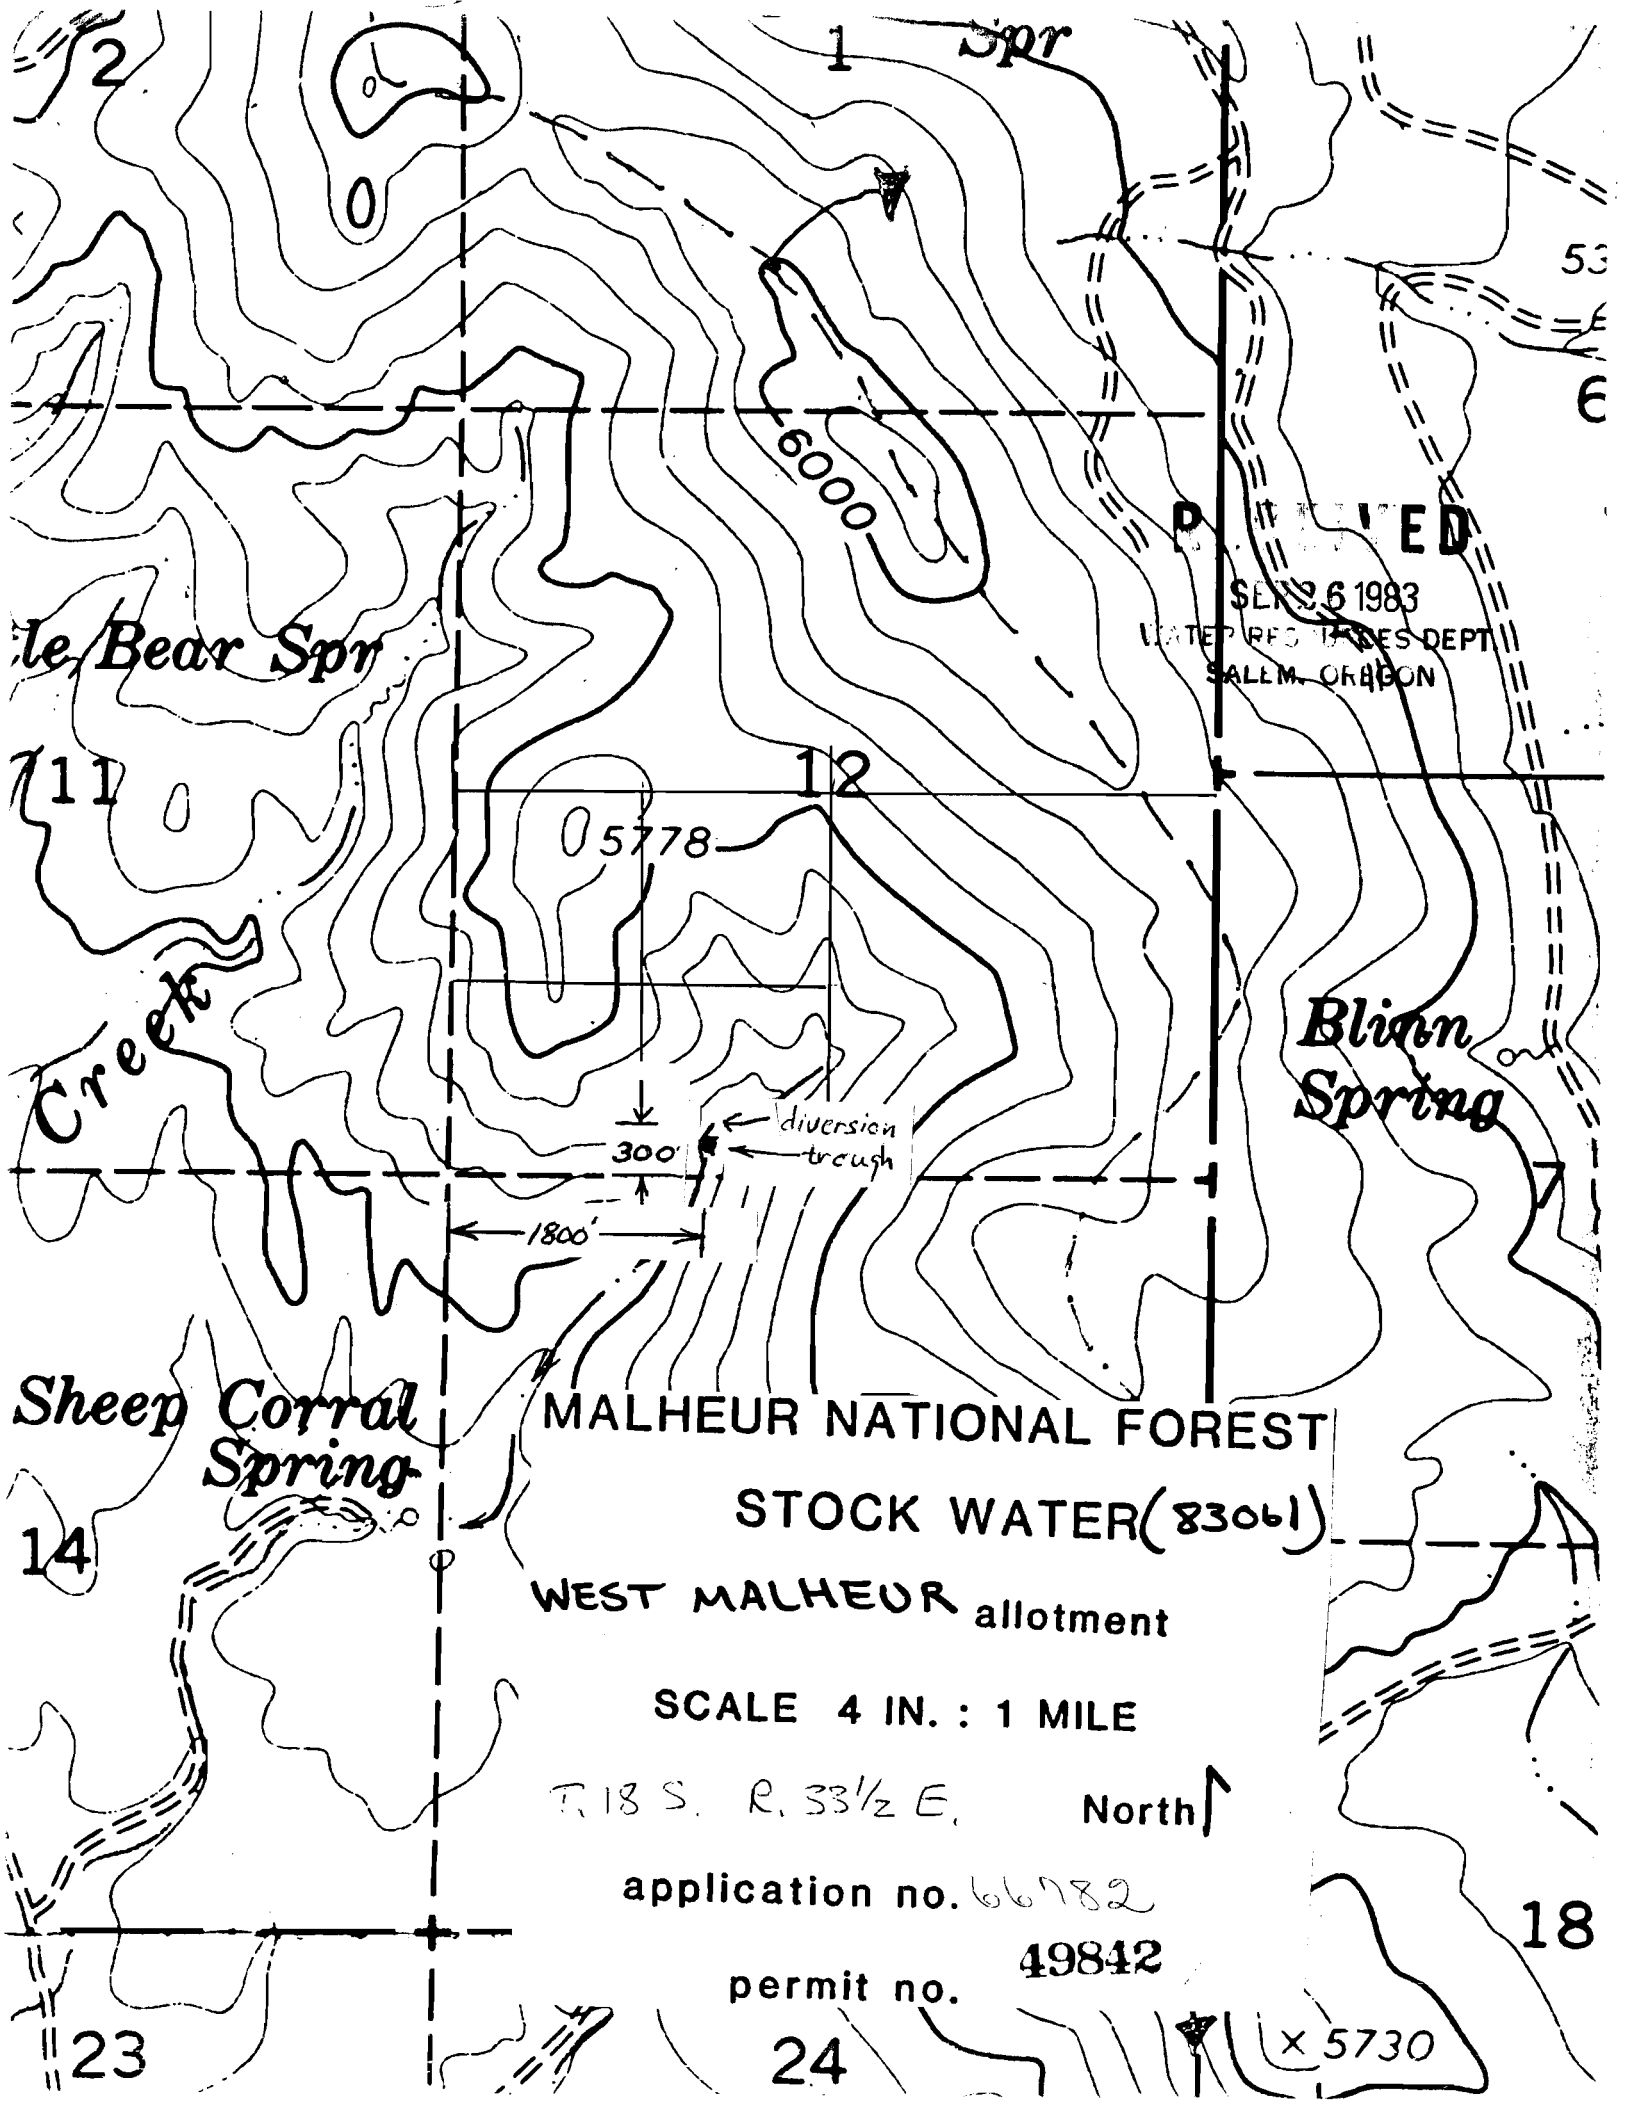

1 Spr

5778

6000

6200

53

6

11

12

300

1800

diversion trough

Blinn Spring

Sheep Corral Spring

14

18

23

24

5730

SENT 6 1983

WATER RESOURCES DEPT

SALEM, OREGON

MALHEUR NATIONAL FOREST

STOCK WATER(83061)

WEST MALHEUR allotment

SCALE 4 IN. : 1 MILE

T. 18 S. R. 33 1/2 E.

North

application no. 66782

permit no. 49842

X 5730