


PAID

OCT 11 1983

WATER RESOURCES DEPT.
SALEM, OREGON

Application No. 67504
Permit No. 50363

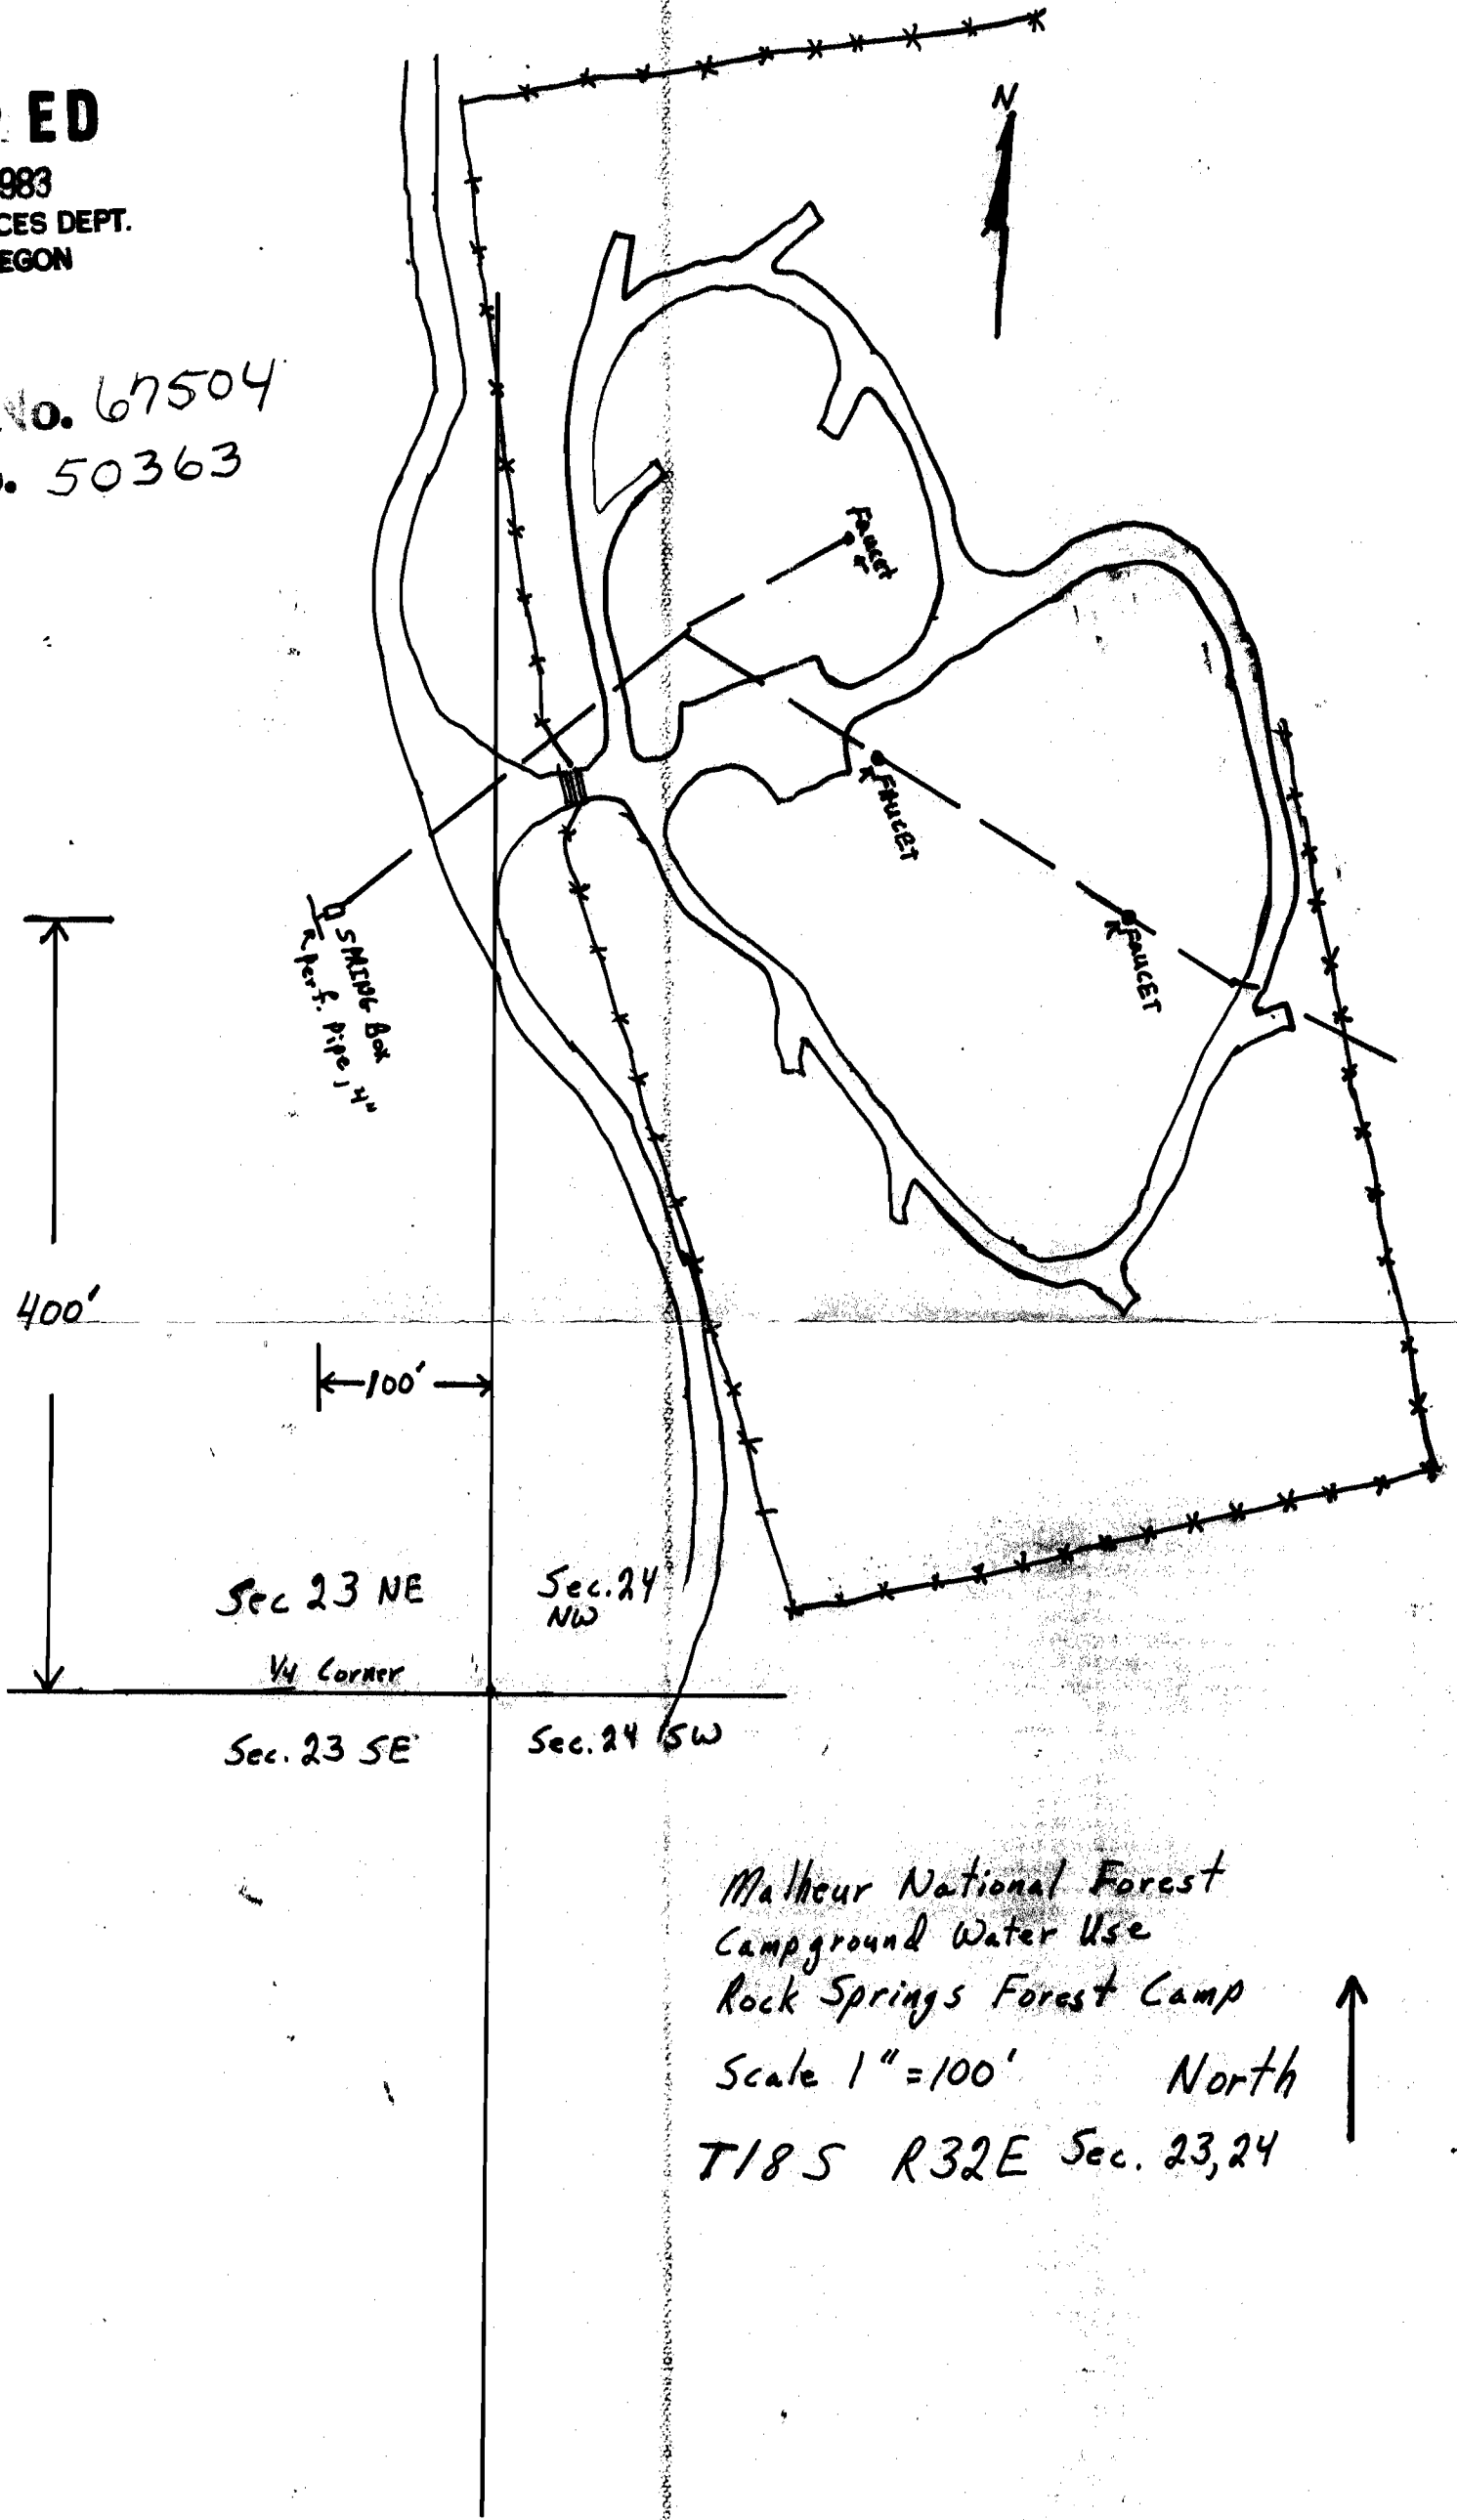

Malheur National Forest
Campground Water Use
Rock Springs Forest Camp
Scale 1"=100' North
T18S R32E Sec. 23,24