


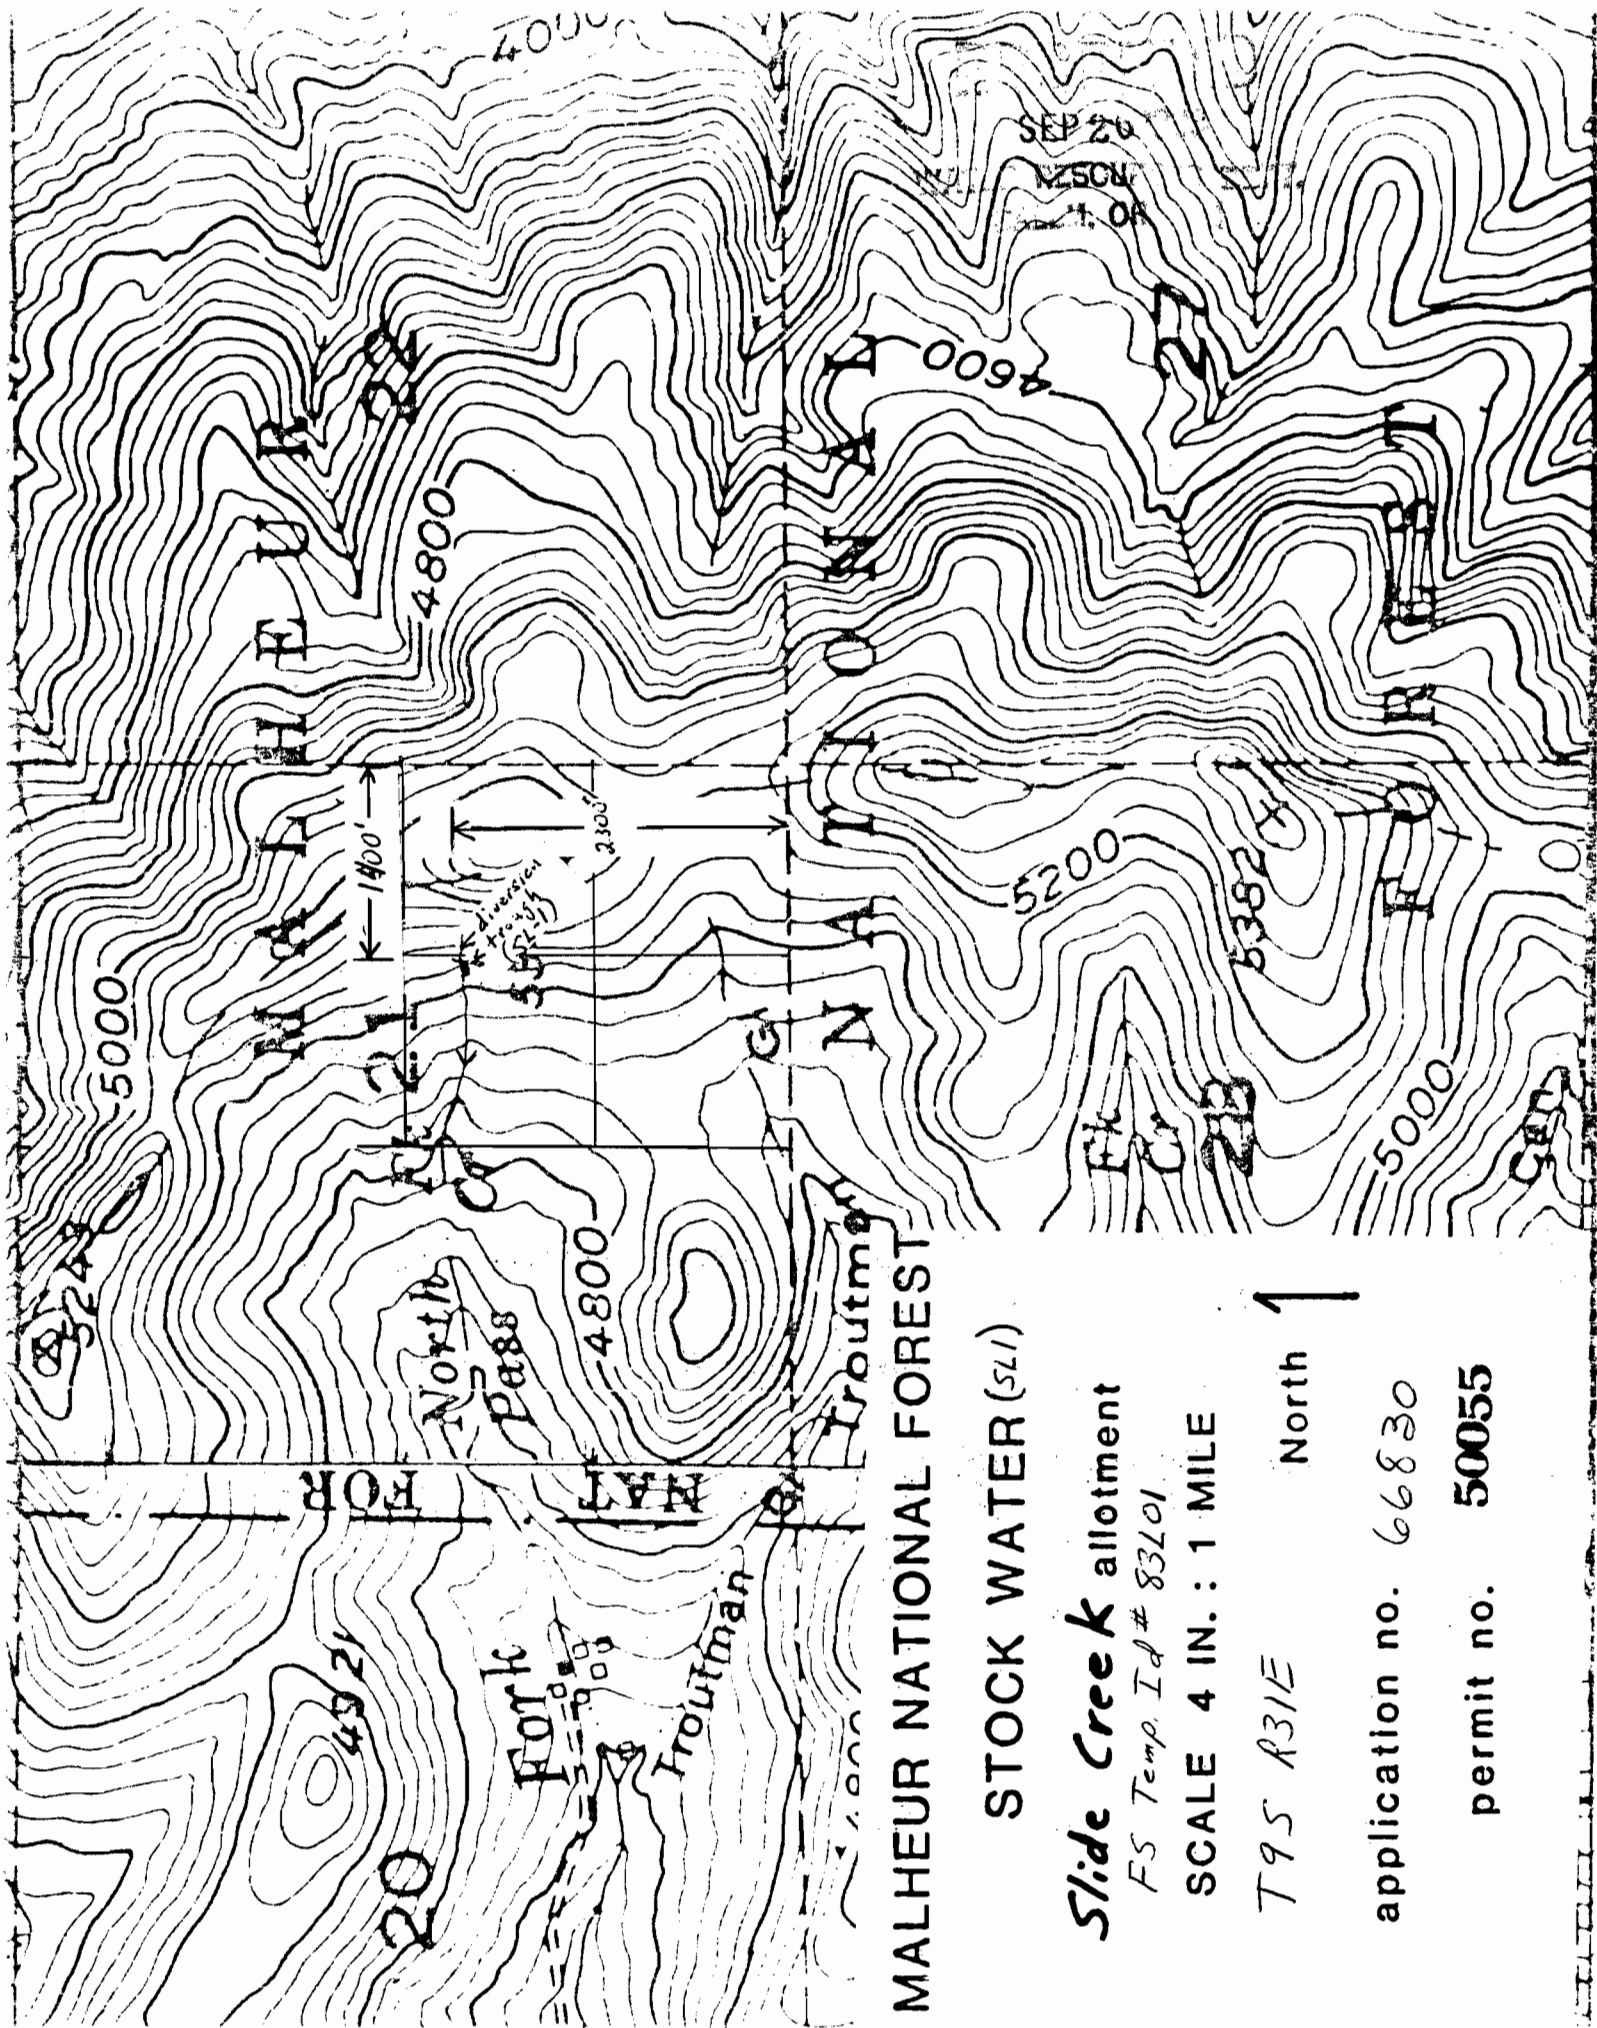

MALHEUR NATIONAL FOREST

STOCK WATER (SLI)

*Slide Creek* allotment

FS Temp. Id # 83101

SCALE 4 IN. : 1 MILE

T95 R31E

North ↑

application no. 66830

permit no. 50055