

MALHEUR NATIONAL FOREST


STOCK WATER

Blue Bucket allotment

FS Temporary Id. # 83P27
SCALE 4 IN. : 1 MILE

application no. 69487 North

permit no. 50357

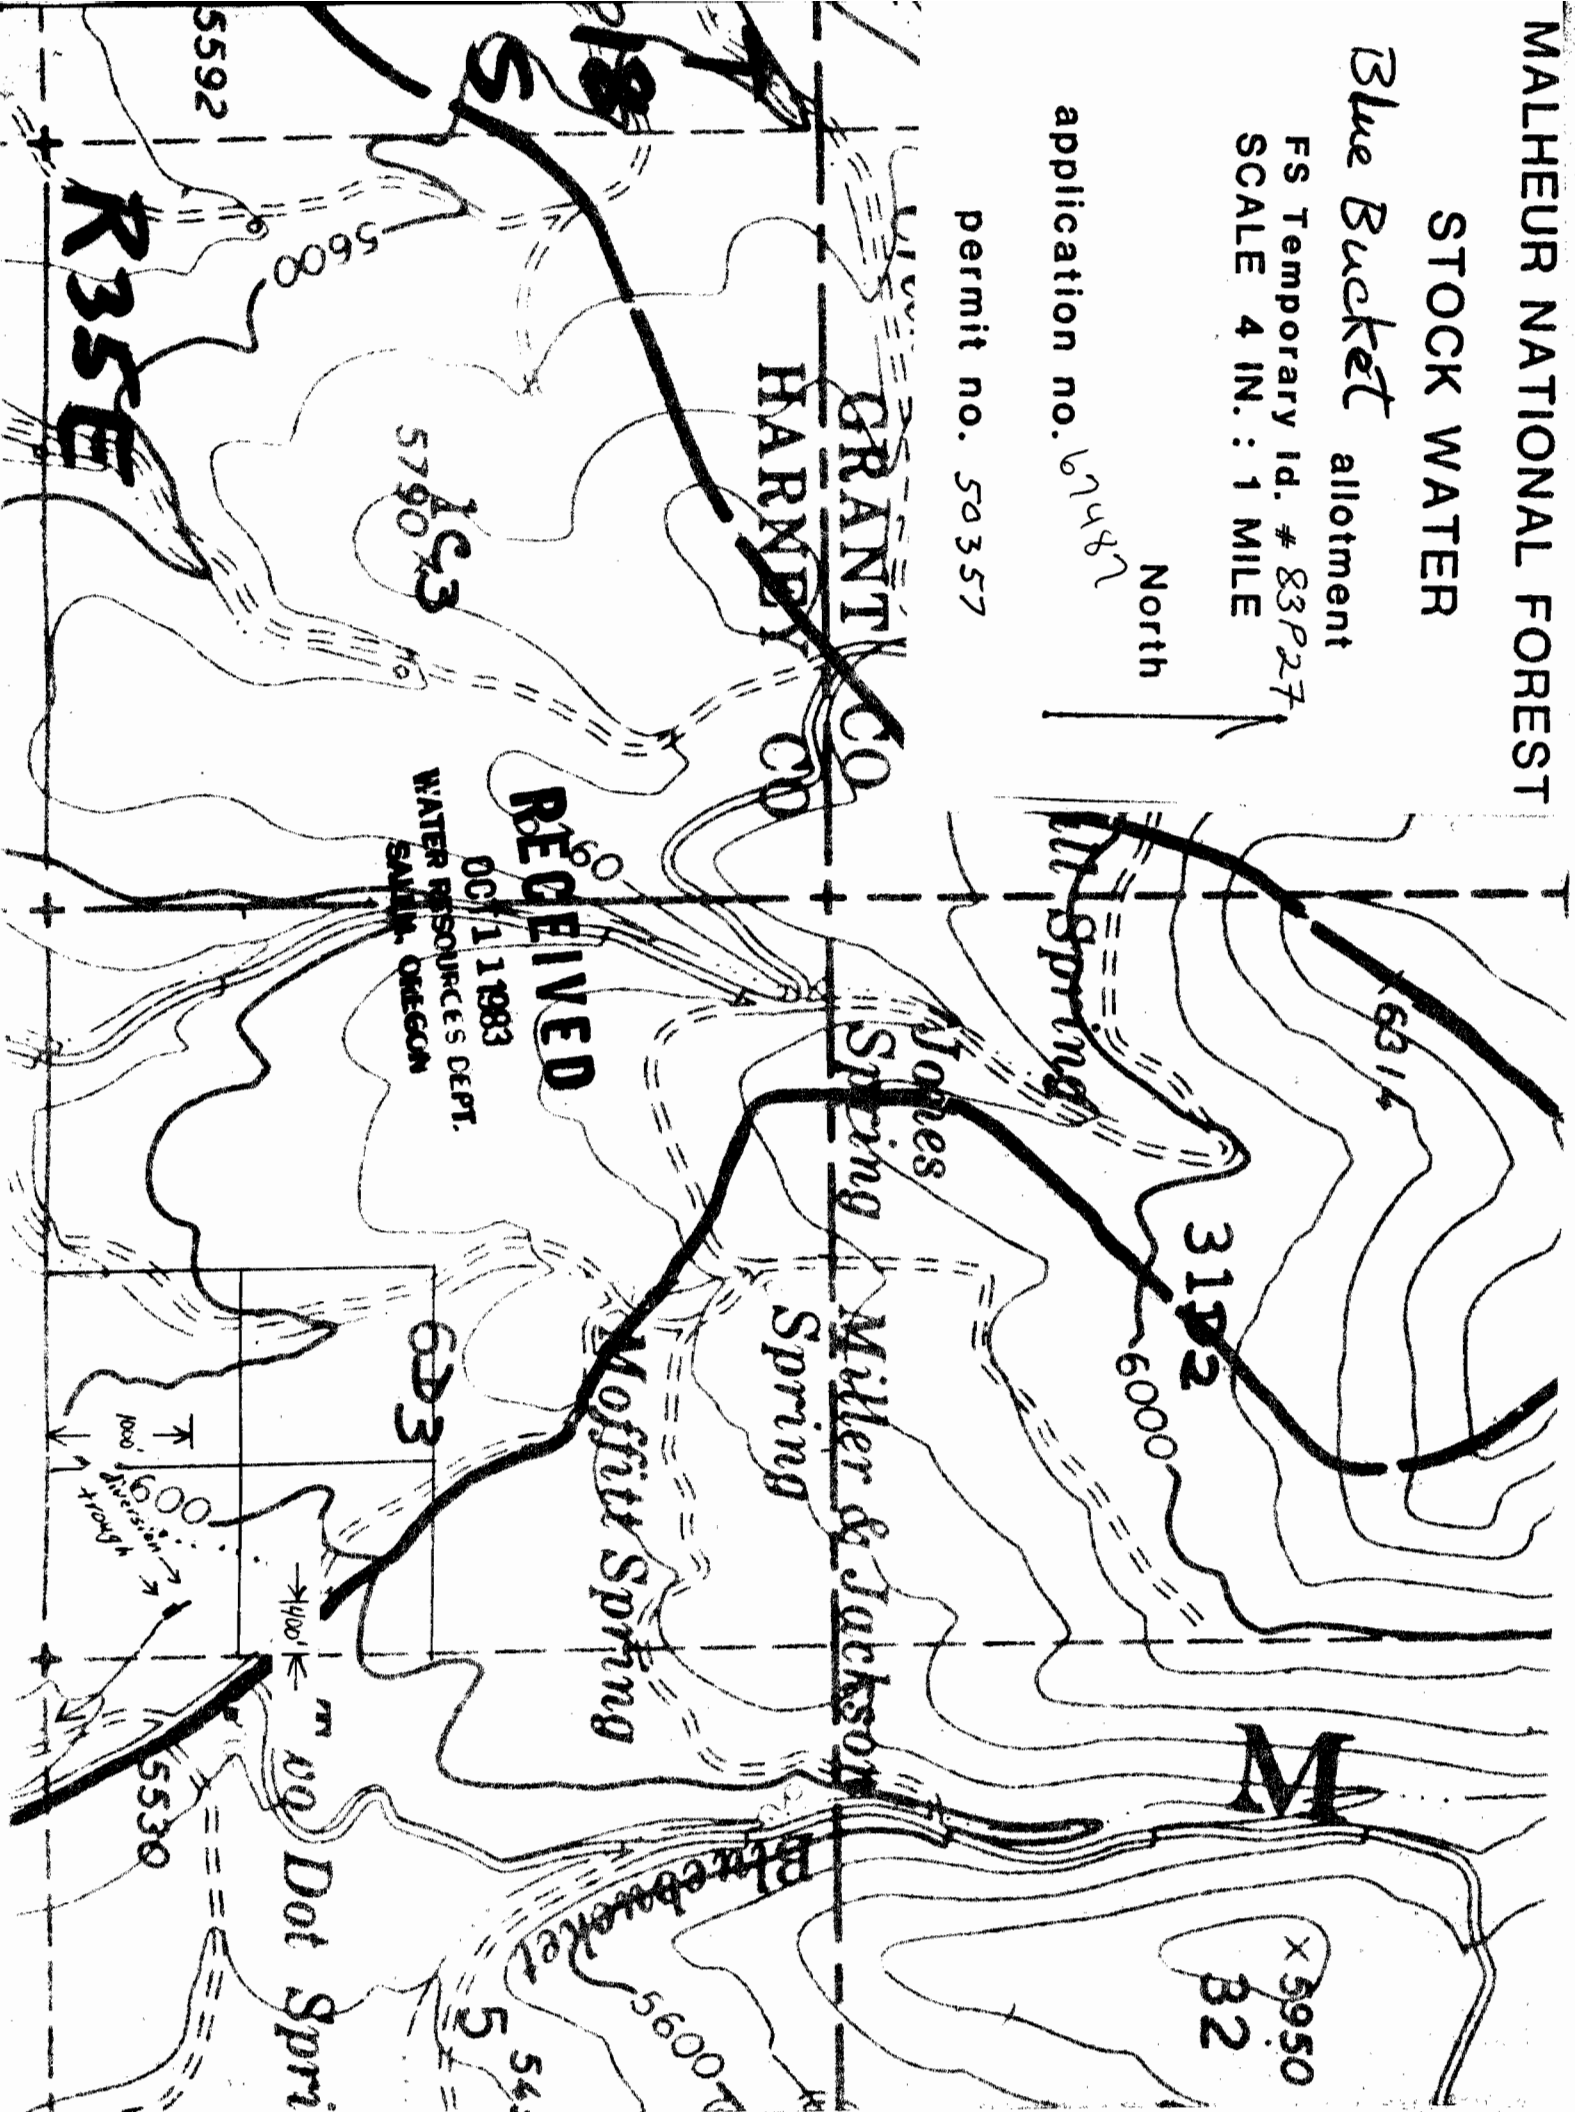

RECEIVED

OCT 1 1983
WATER RESOURCES DEPT.
SALM, OREGON

R35E

5592

5790

5600

GRANT CO
HARNEY CO

Jones Spring

X 6314

3192

6000

Miller & Jackson Spring

Moffitt Spring

623

X 5950
32

Blue Bucket

Dot Spring

5530

600

1400'

1400'

Dot Spring