


SECTION

TOWNSHIP 16S, RANGE 36E, W. M.  
SW-6

North

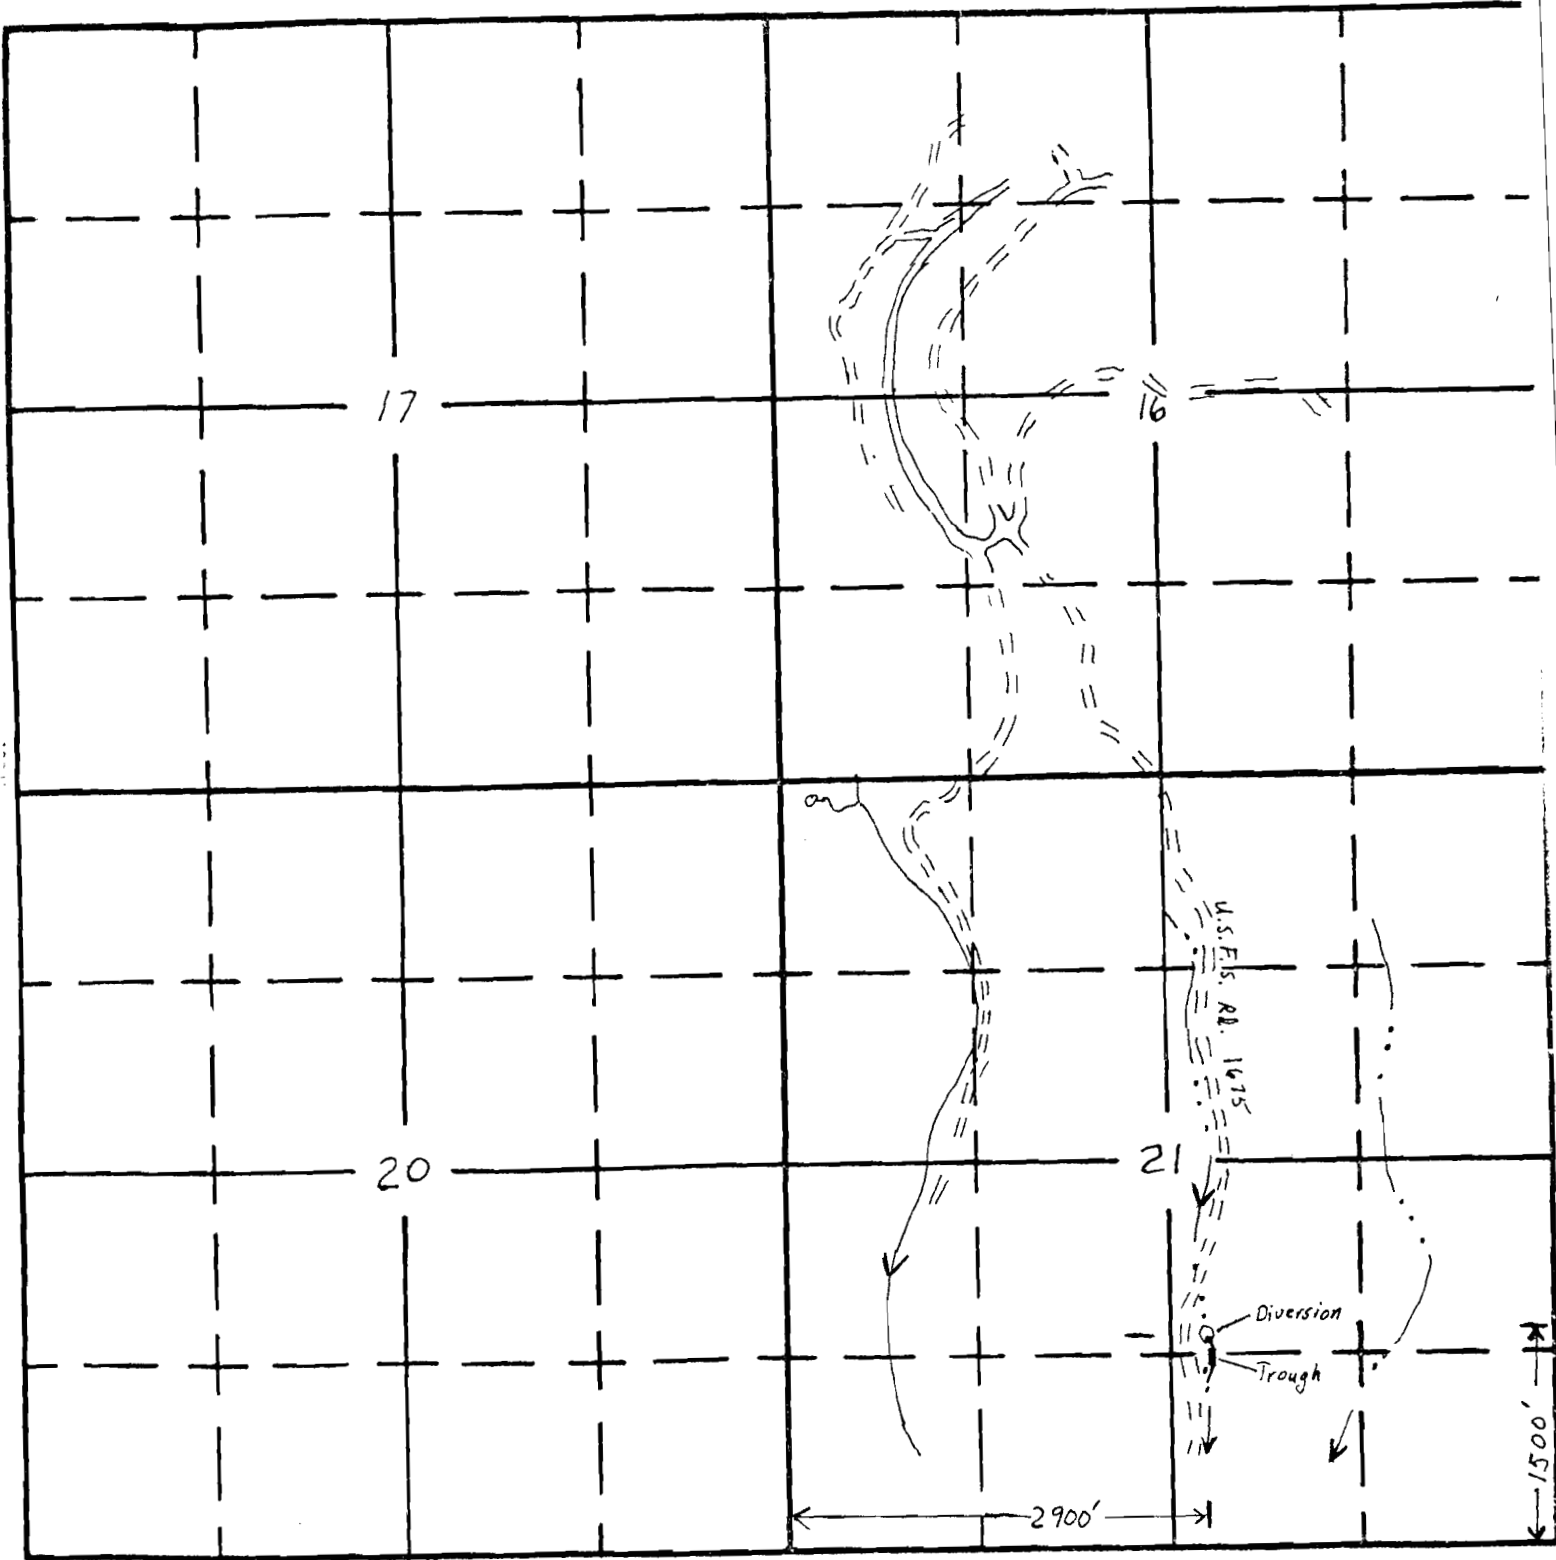

South

**RECEIVED**

JAN 17 1983

WATER RESOURCES DEPT.  
SALEM, OREGON

APPLICATION No. 62086

PERMIT No.

**47396**