


APPLICATION MAP FOR FLAG PRAIRIE ALLOTMENT

scale 4" : 1 mi. SW-16

NORTH ↑

Application No. 62080

Permit No. **47390** T16S R35E

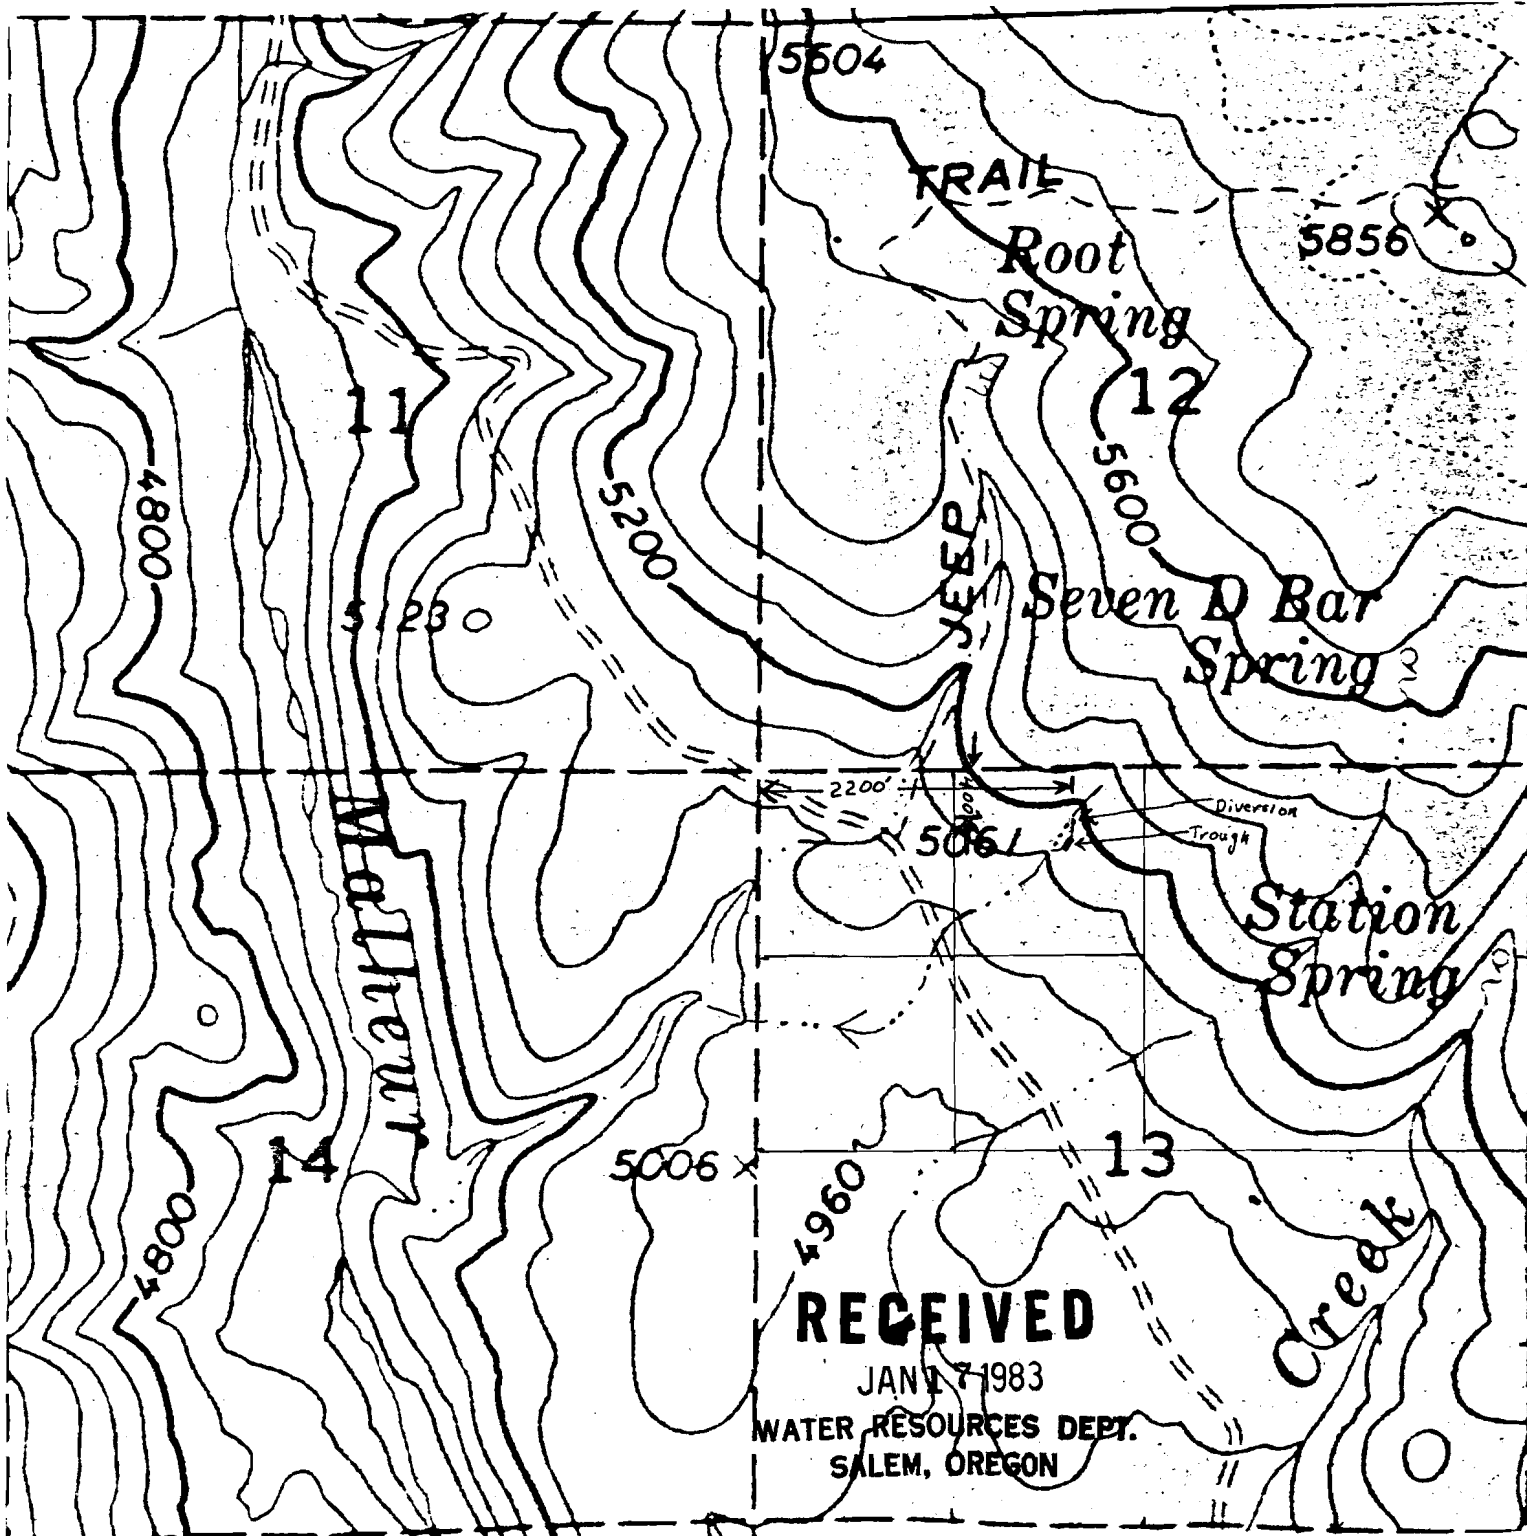

RECEIVED
JAN 7 1983
WATER RESOURCES DEPT.
SALEM, OREGON