

APPLICATION MAP FOR FLAG PRAIRIE ALLOTMENT

scale 4" : 1 mi.

56-24

NORTH


Application No. 62078

Application No.

47388 T16S

R35E

Permit No.

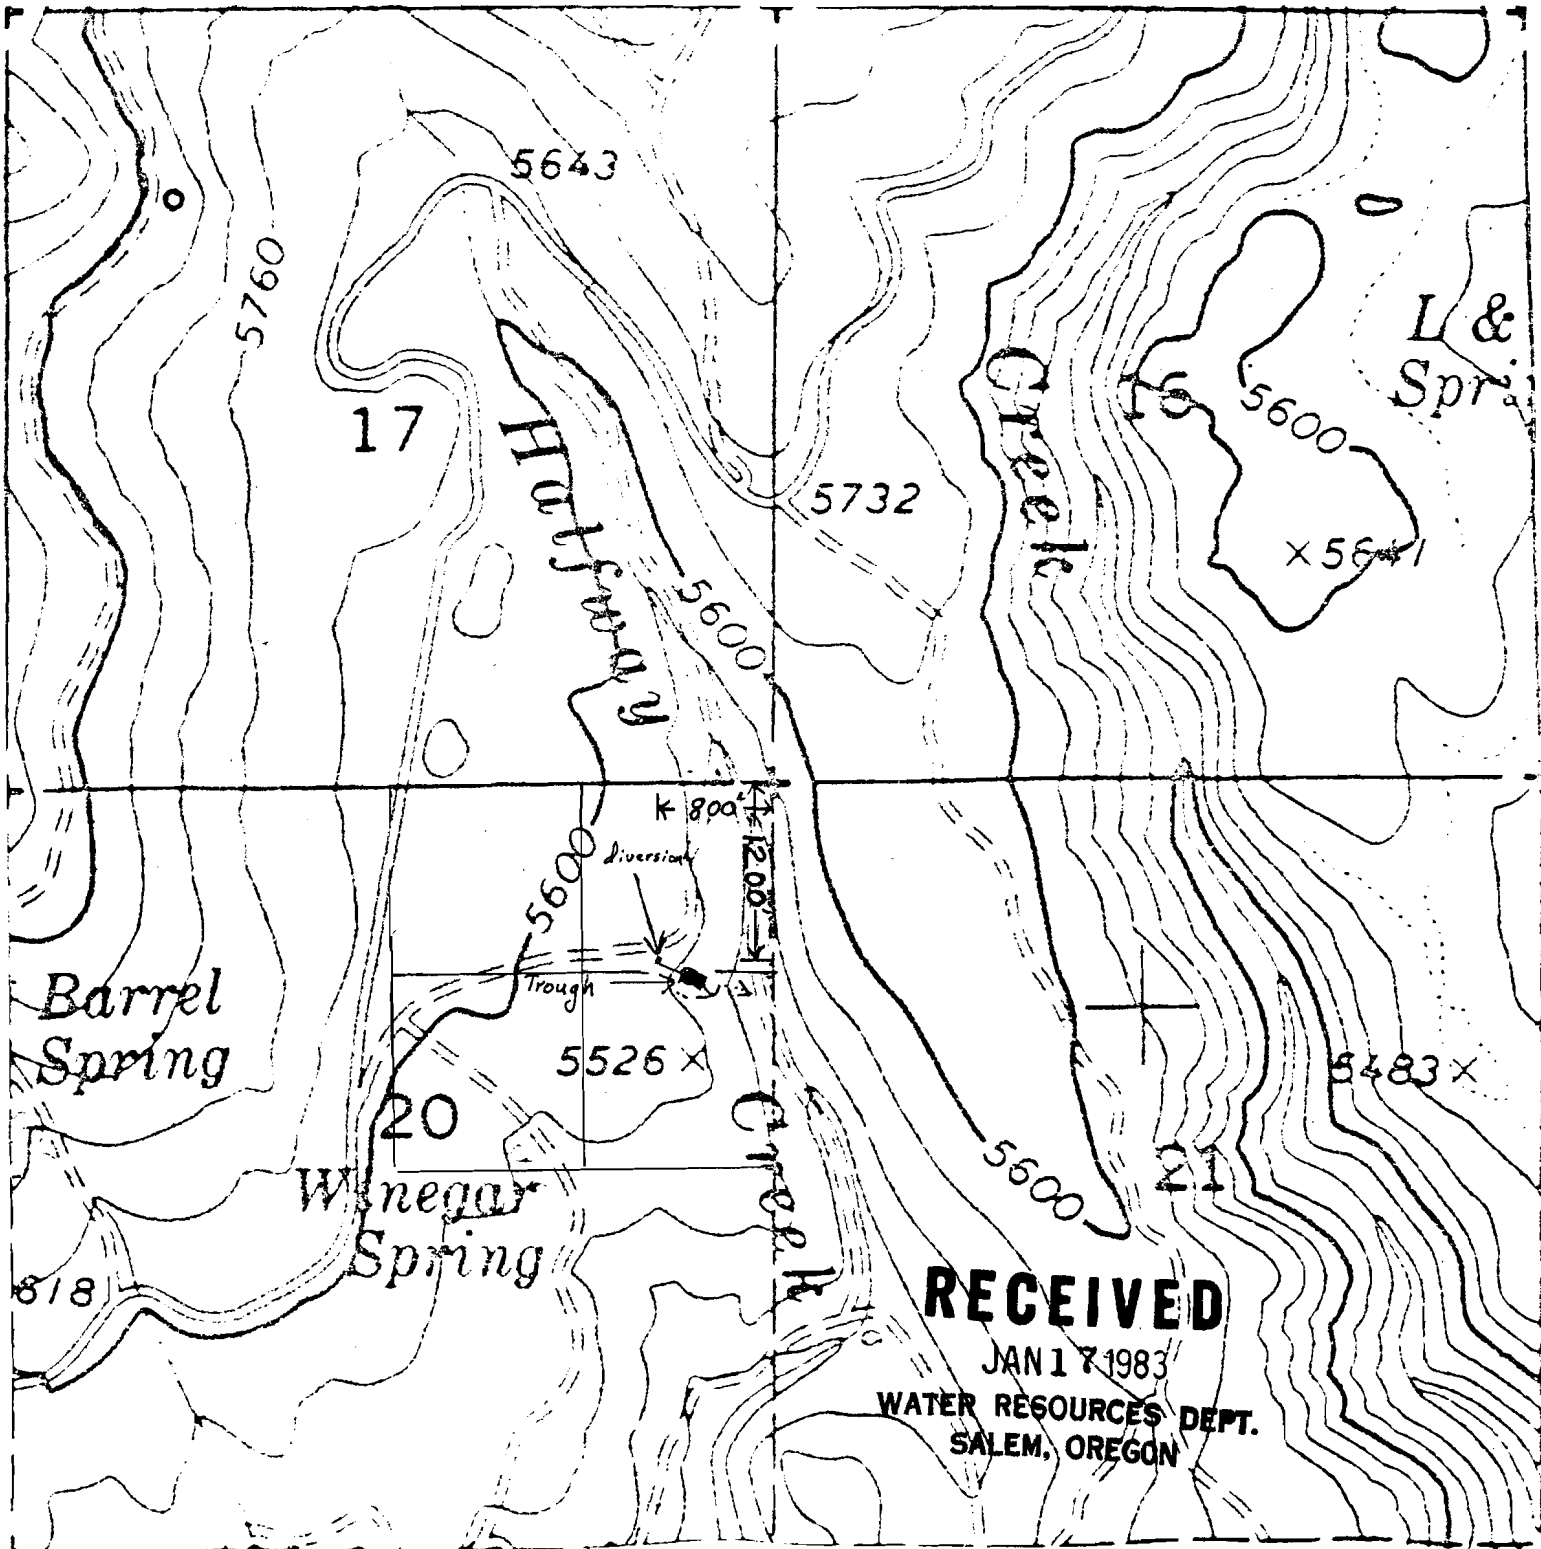

**RECEIVED**

JAN 17 1983

WATER RESOURCES DEPT.  
SALEM, OREGON