


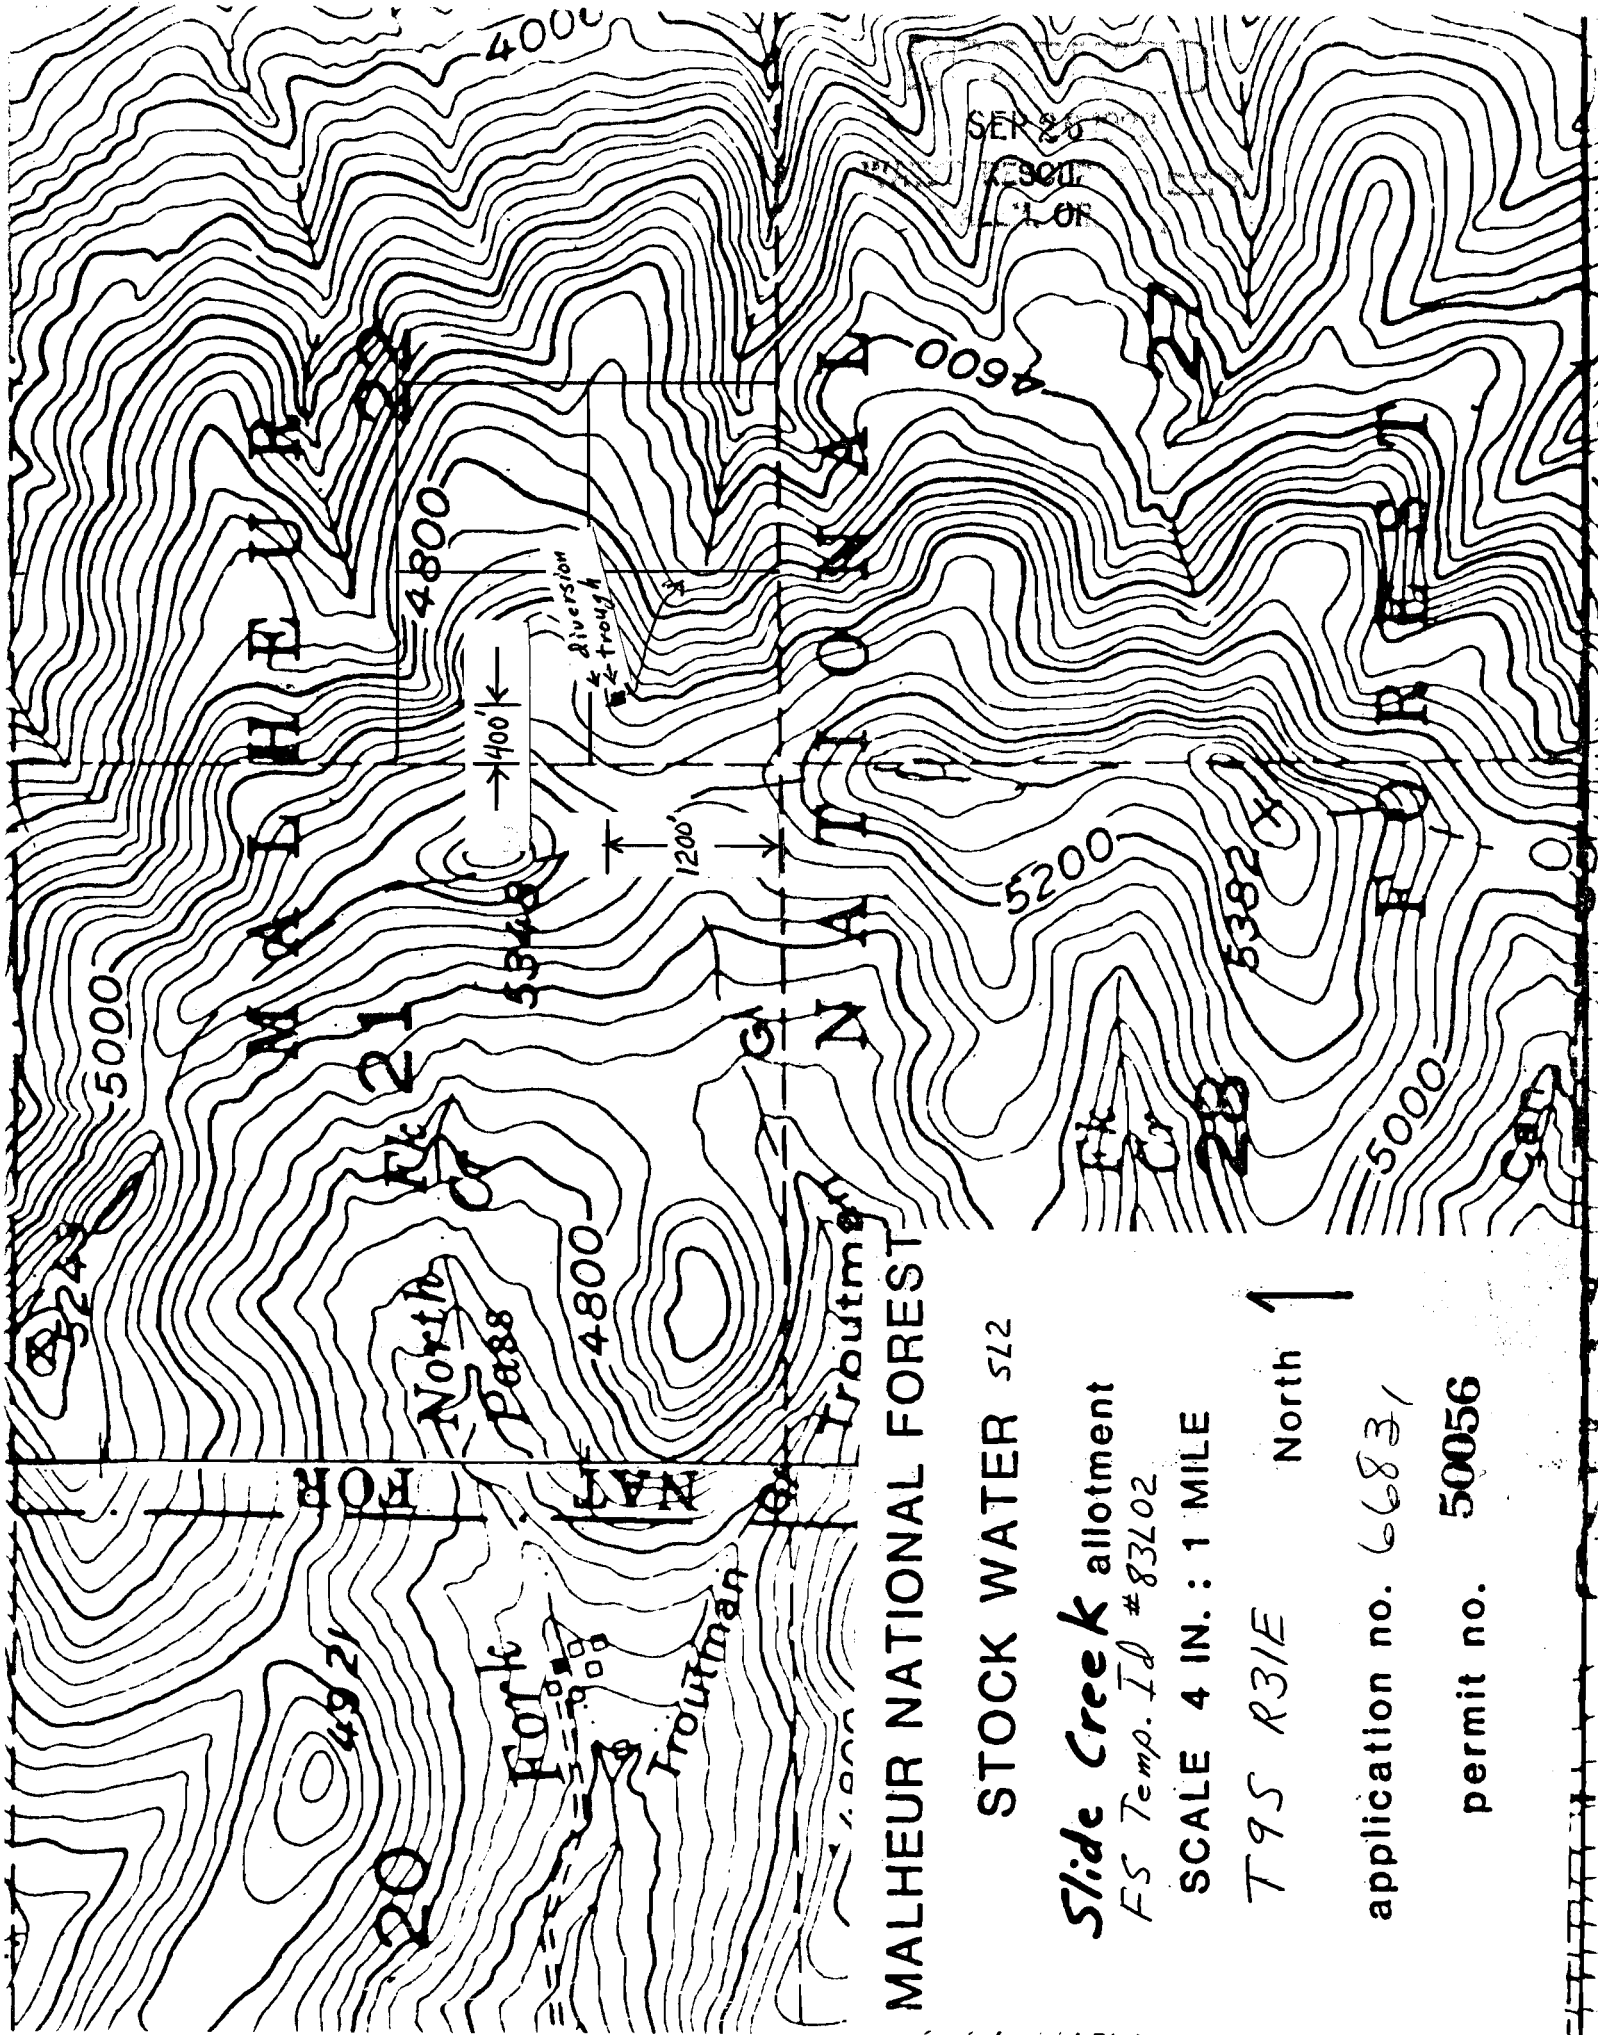


MALHEUR NATIONAL FOREST

STOCK WATER 512

Slide Creek allotment
FS Temp. ID #83102

SCALE 4 IN. : 1 MILE

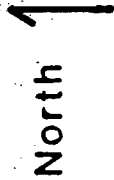T9S R3/E North 

application no. 66831

permit no. 50056