

R34E



Application No. 58505
Permit No. 44158

4


9,625'S

RECEIVED

APR 09 1979

WATER RESOURCES DEPT.
SALEM, OREGON

T17S

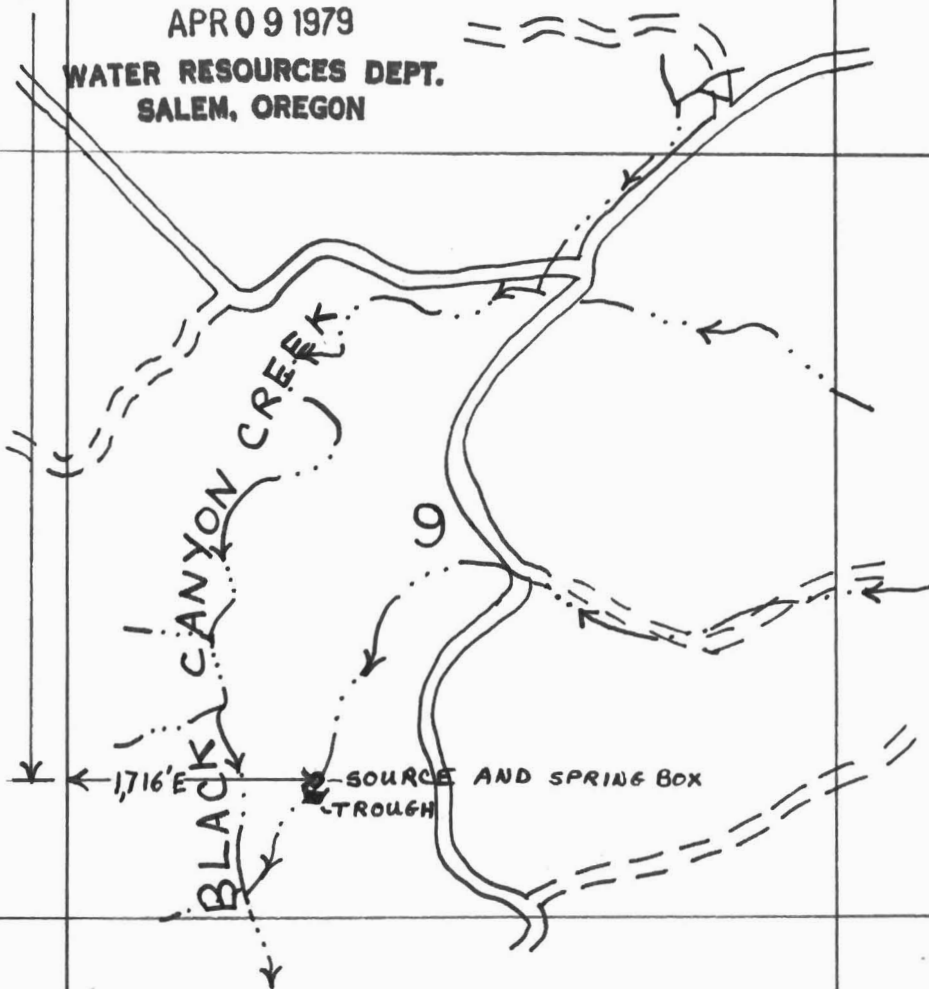

SCALE: 4" = 1 MILE