


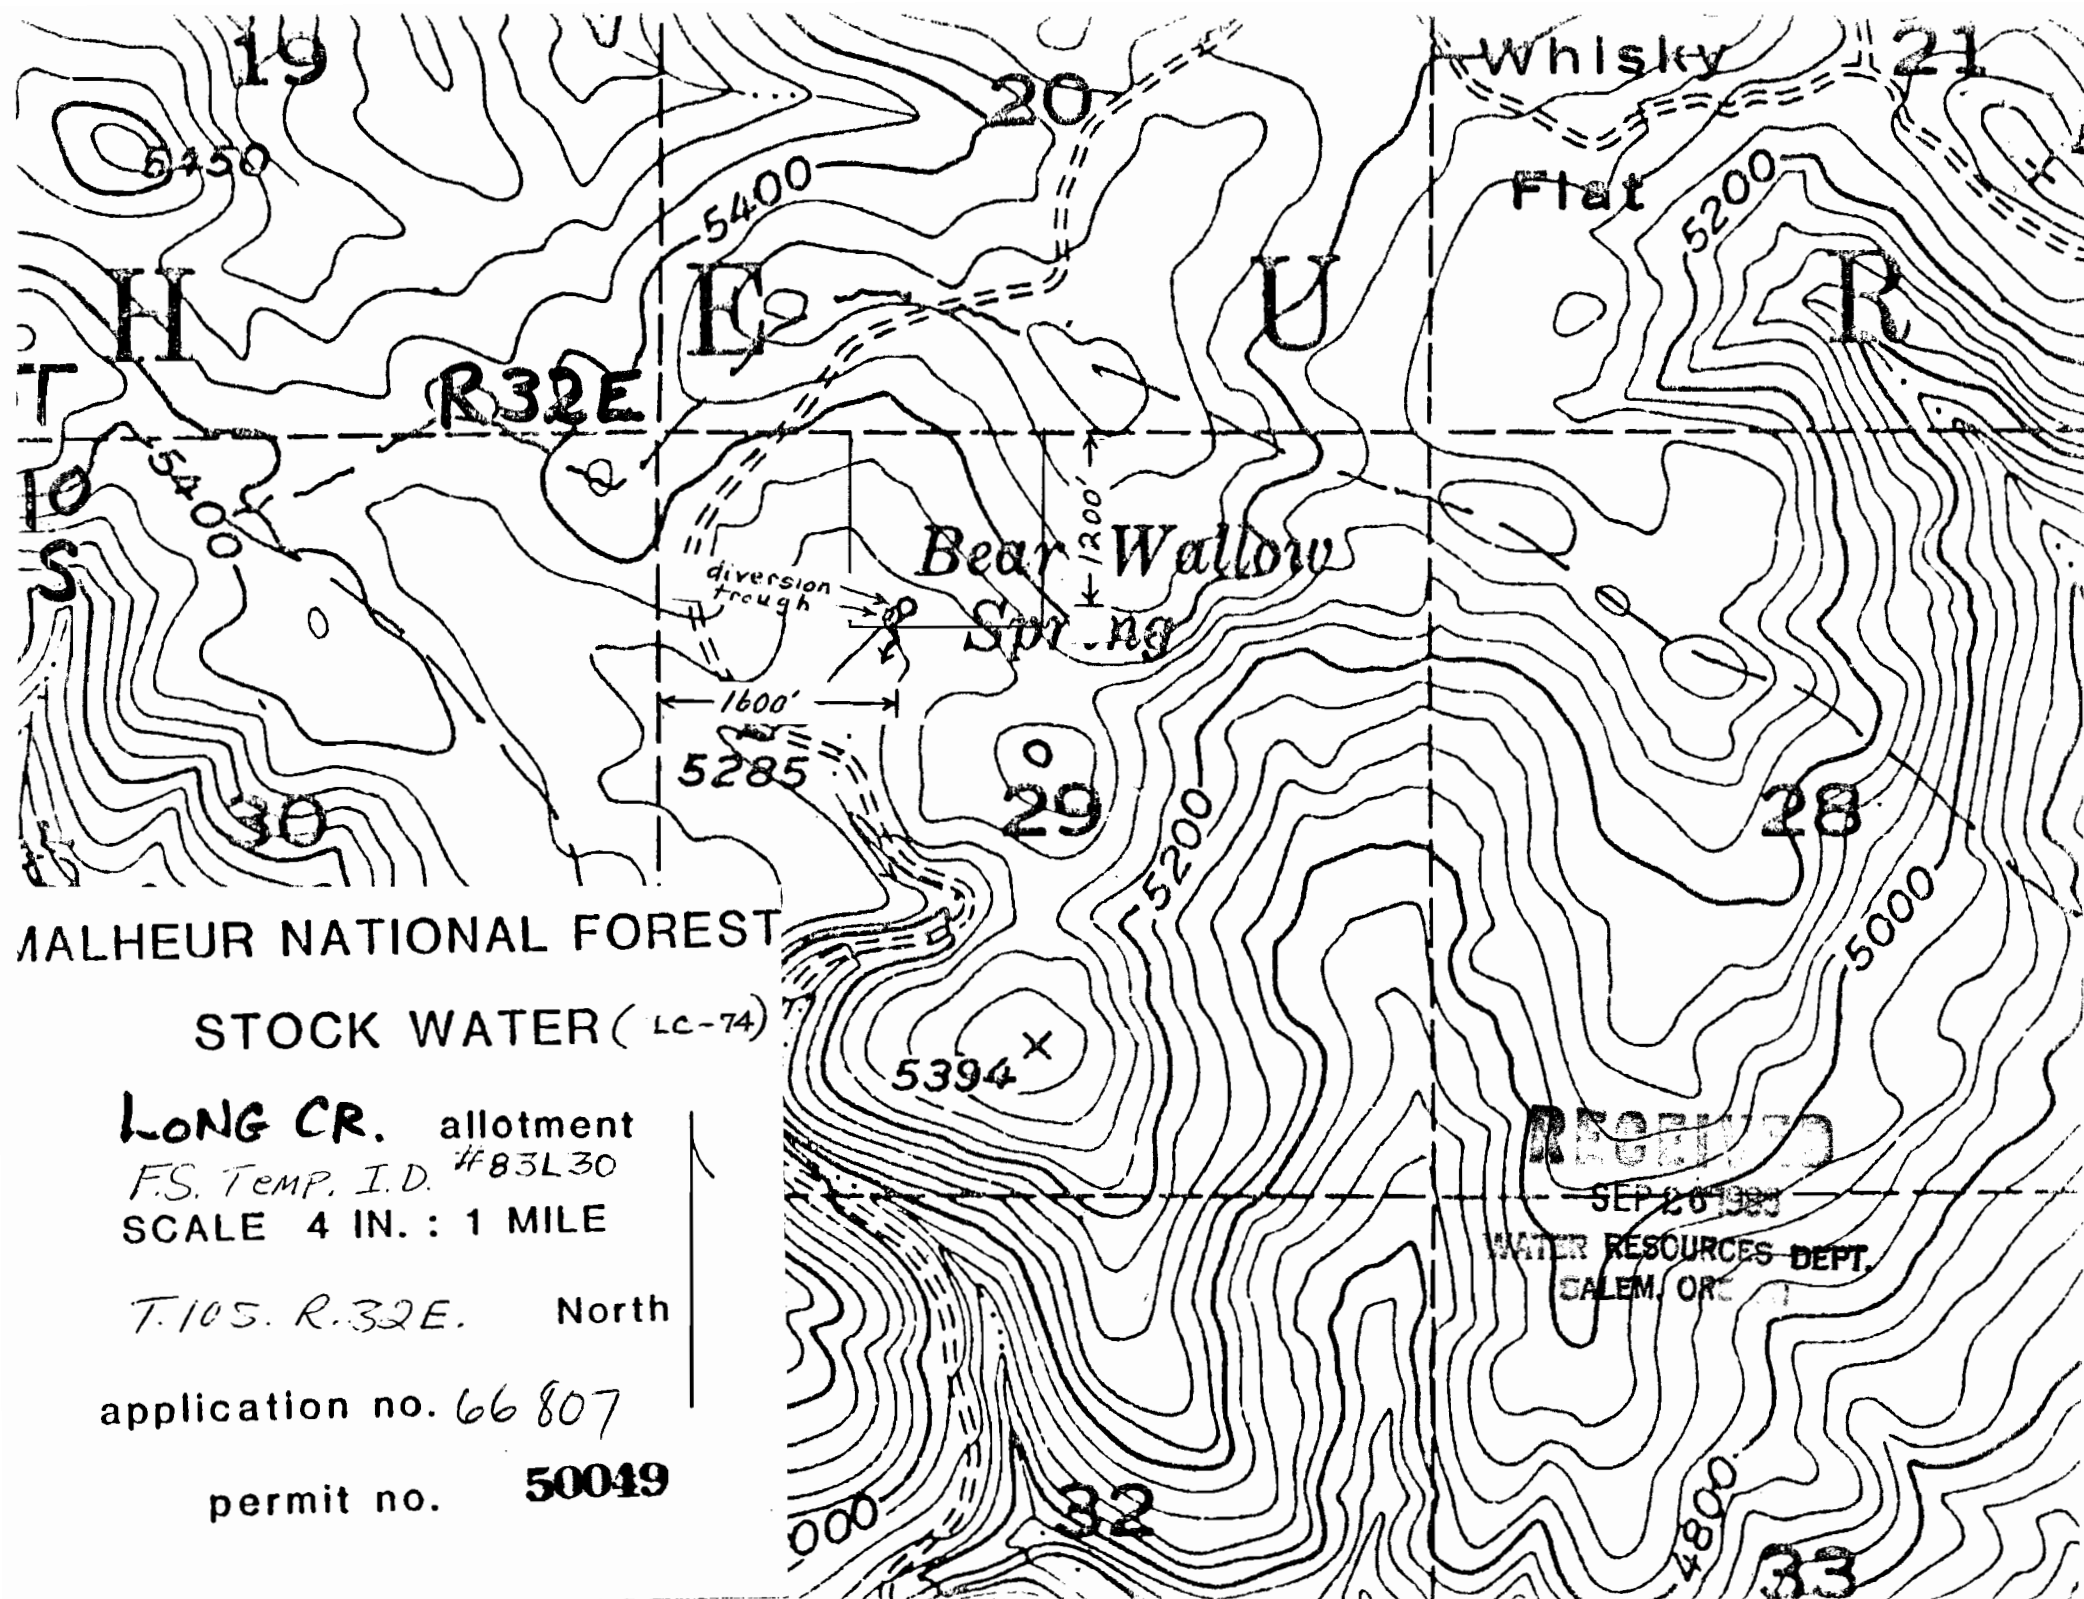

19

20

21

Whisky

Flat

5200

R32E

Bear Wallow
Spring

diversion
trough

1600'

5285

29

5200

28

5000

5394 X

MALHEUR NATIONAL FOREST

STOCK WATER (LC-74)

LONG CR. allotment

F.S. Temp. I.D. #83L30

SCALE 4 IN. : 1 MILE

T. 10 S. R. 32 E. North

application no. 66 807

permit no. 50049

RECEIVED

SEP 26 1983

WATER RESOURCES DEPT.
SALEM, ORE

000

32

33