MALHEUR NATIONAL FOREST

STOCK WATER

BLUE BUCKET allotment

FS Temporary Id. # 83P22

SCALE 4 IN. : 1 MILE

North

application no. 67482

permit no. 50355

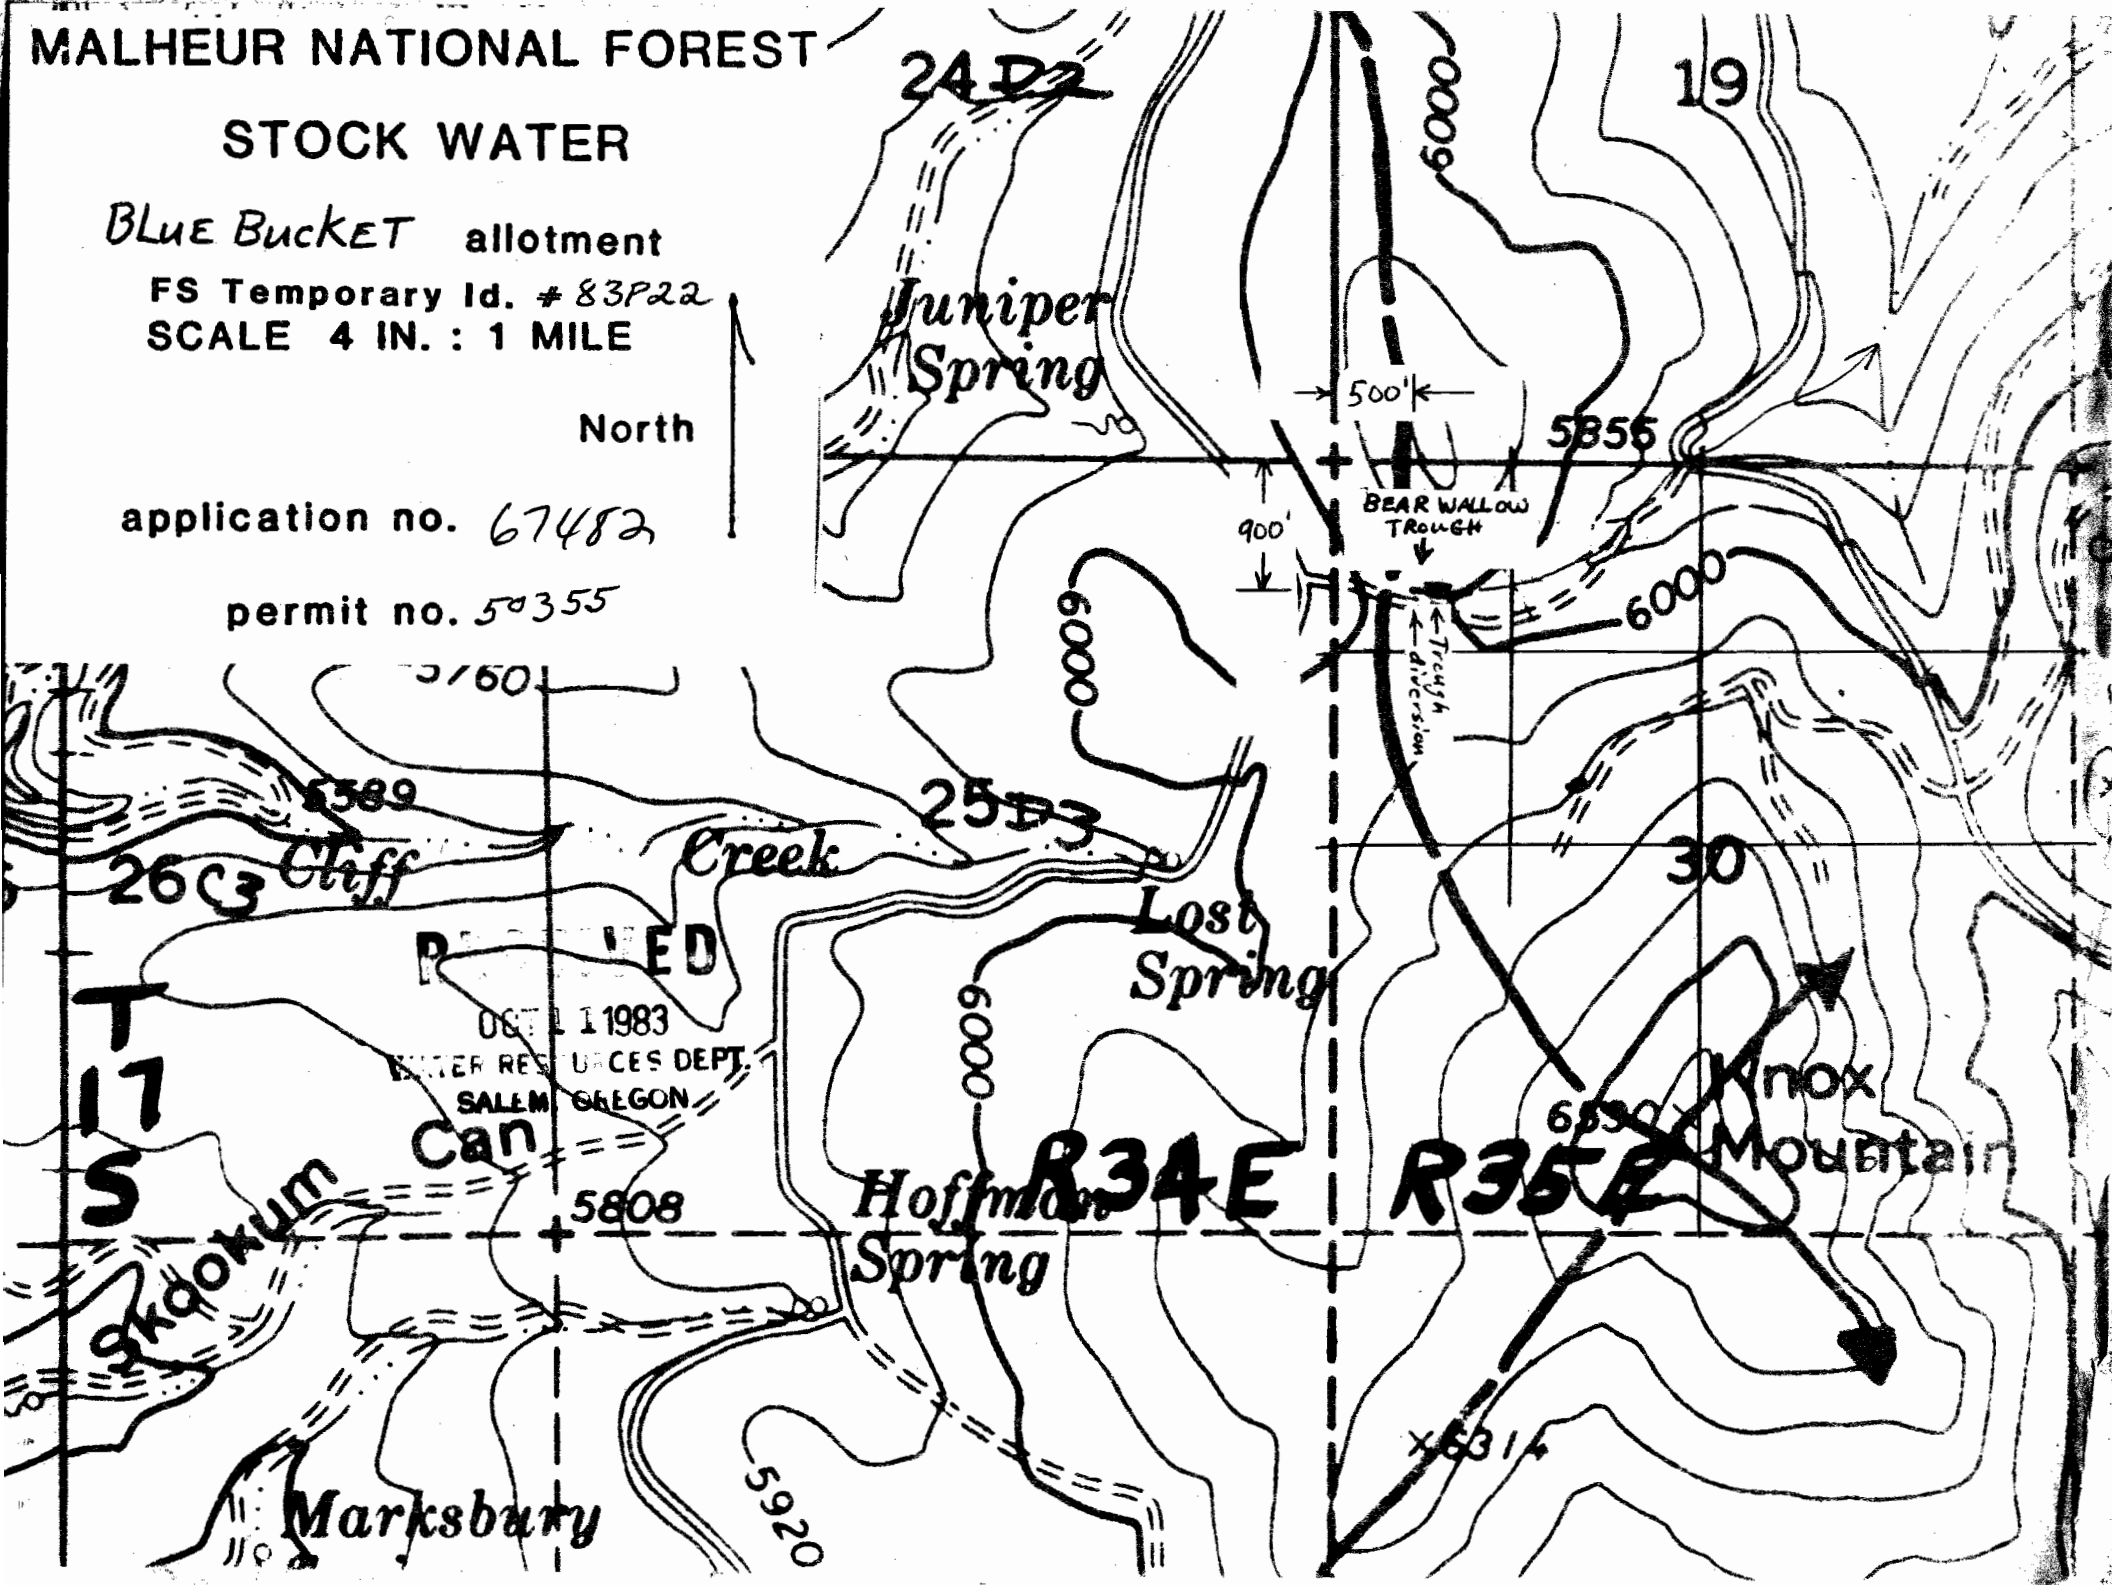

RECEIVED
OCT 11 1983
WATER RESOURCES DEPT.
SALEM, OREGON