


VED  
1983  
CES DEPT.  
REGON

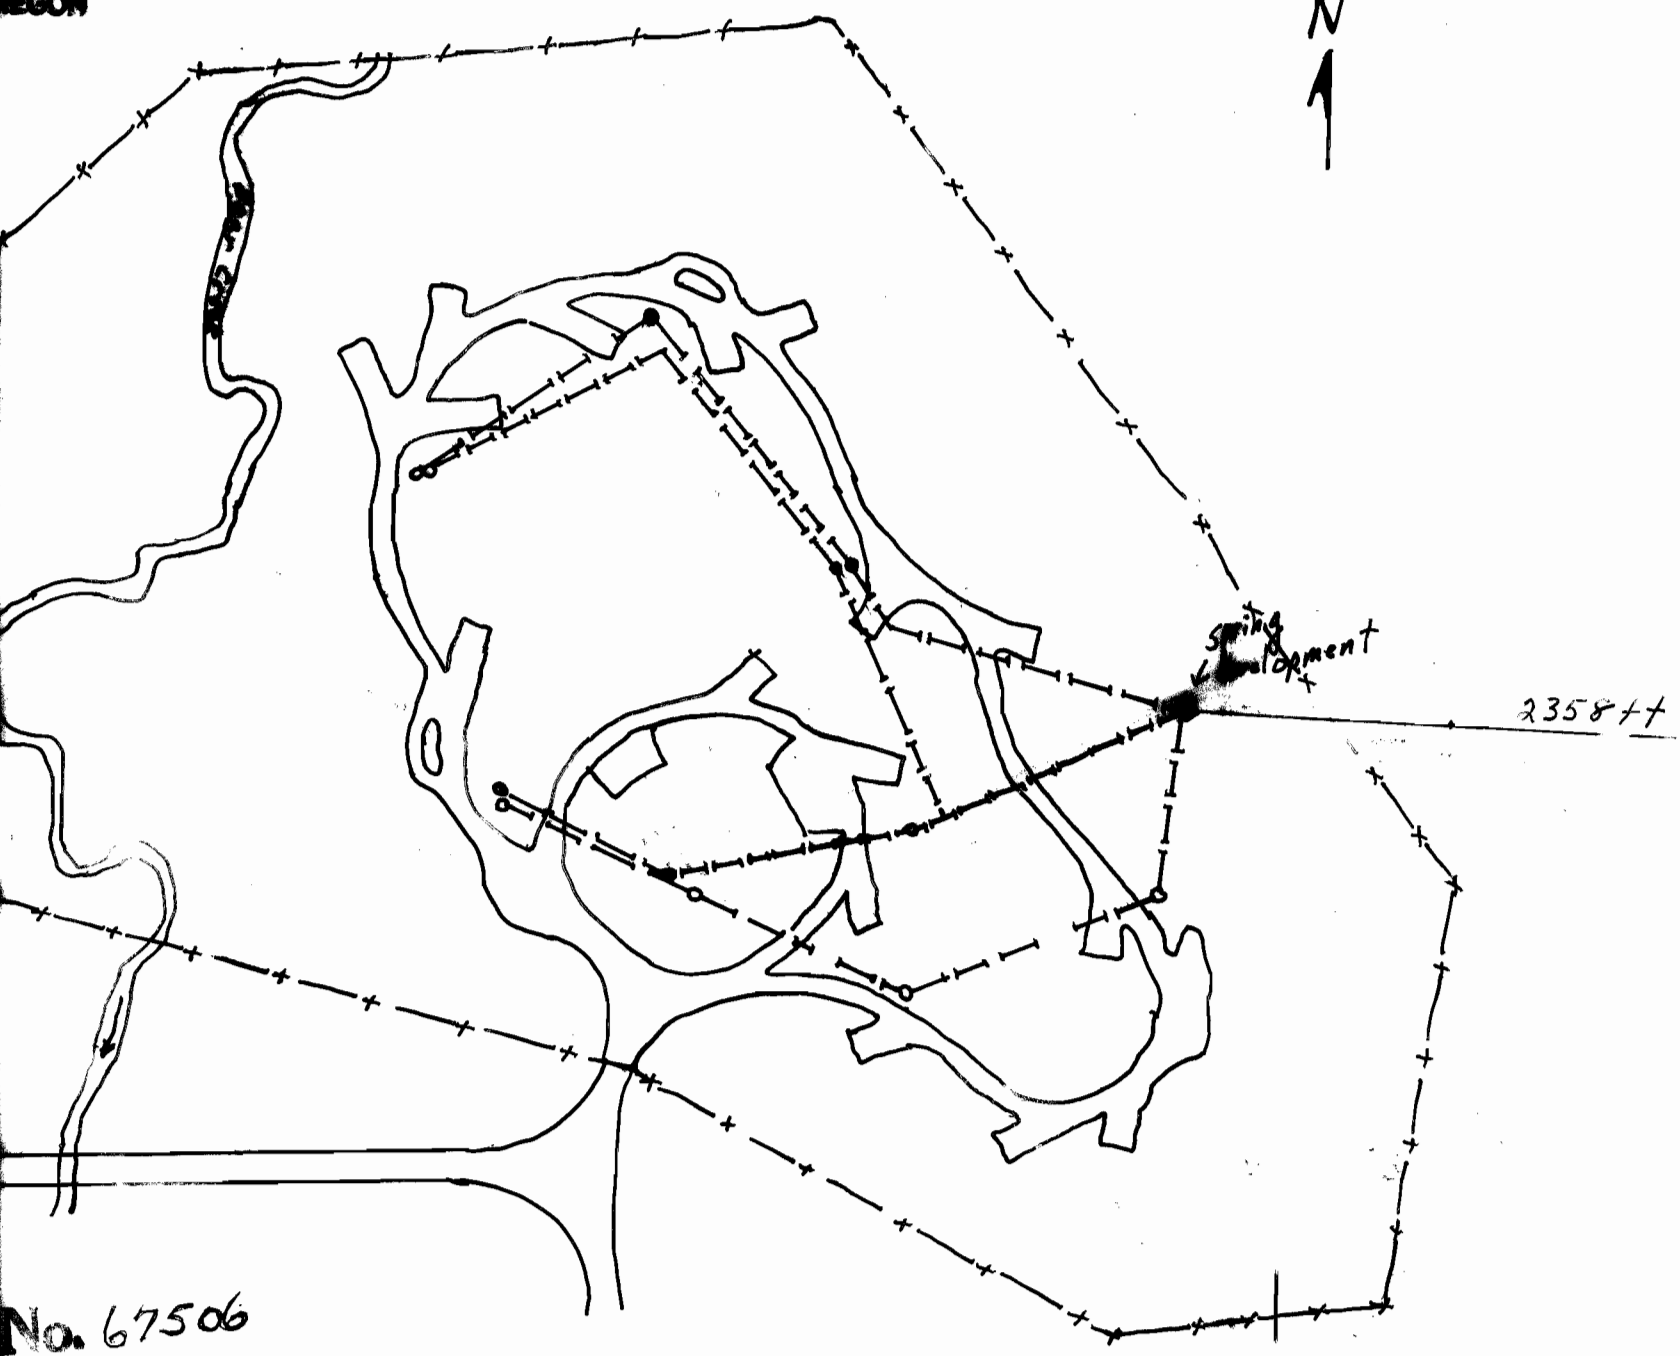

57° Corner  
Section 16  
Tp. 16S R33E  
276°

No. 67506  
50364

Malheur National Forest  
Campground Water Use  
Parish Cabin Campground  
Scale 1" = 120 feet  
T16S R33E Sec. 16  
Pipeline - - - - -  
faucet/hydrants • (not all faucets are shown)