


BUREAU OF LAND MANAGEMENT

WHITE ROCK RESERVOIR

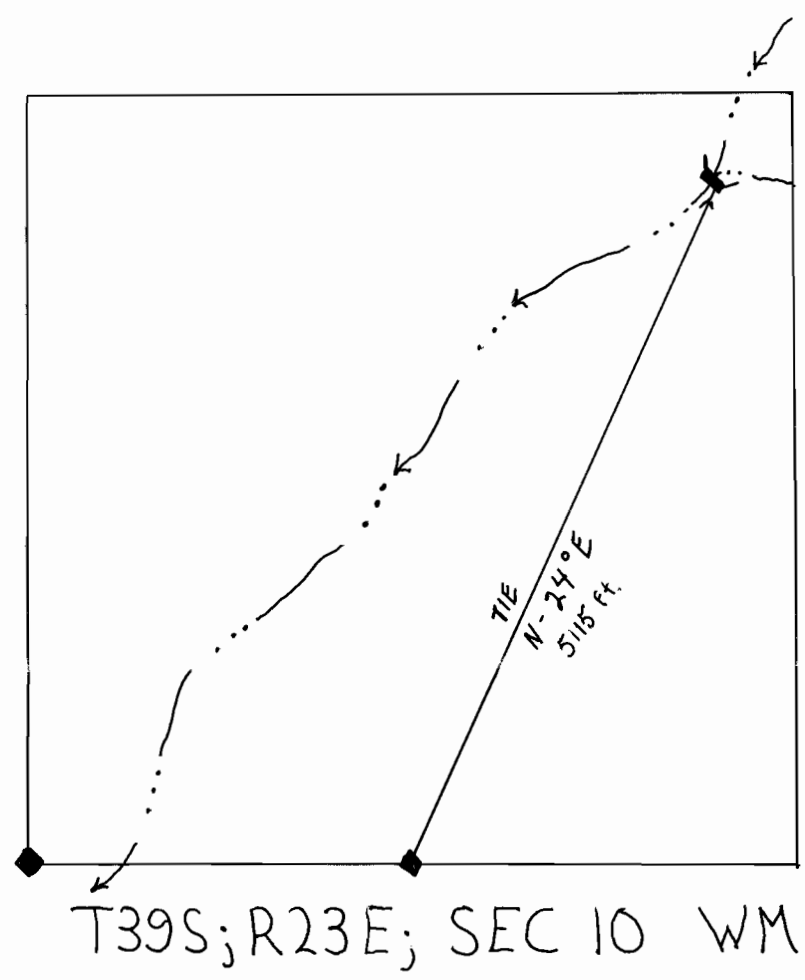

Application No. R-33716
Permit No. R-2344

lam 9/60