

X 6428

X 5605

51

14

14

T

5000

R 35 E

5654

23

23

Lost Camp Spring

5600

615

6000

# MALHEUR NATIONAL FOREST

## STOCK WATER

### SPRING CR. allotment


FS Temporary Id. # 83Pφ3

SCALE 4 IN. : 1 MILE

North

application no. R-67463

permit no. R-10909

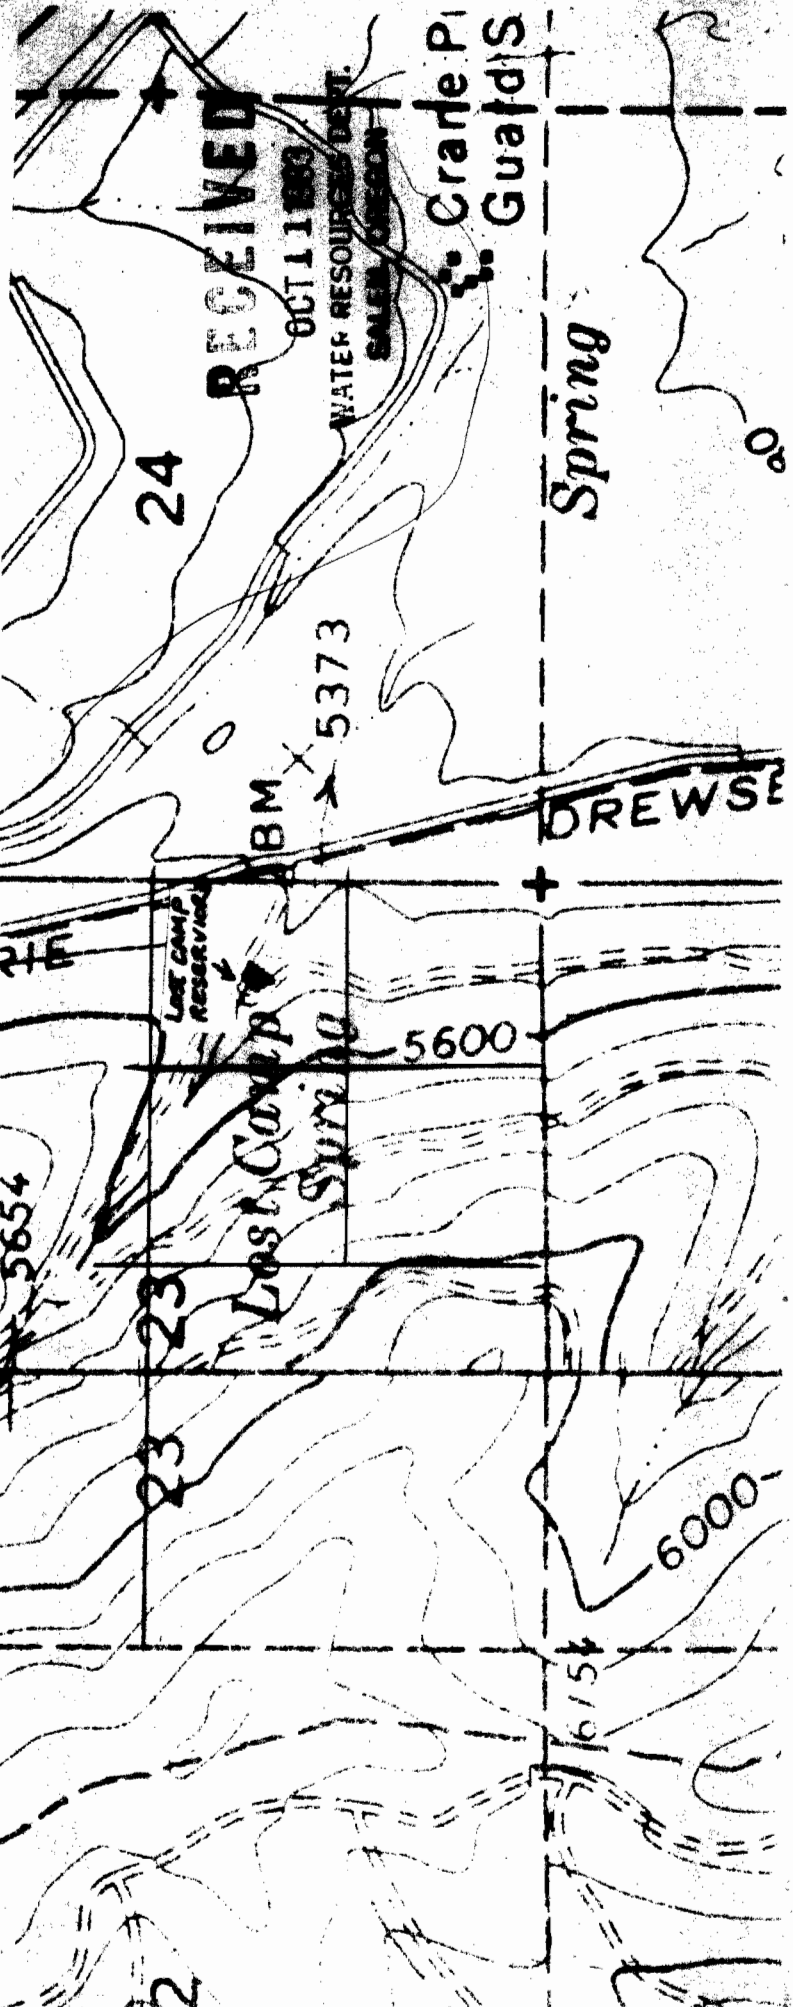

RECEIVED

OCT 11 1960

WATER RESOURCES DEPT.

SALEEN OREGON

Cradle Pt  
Guaid's

Spring

DREWSE

00