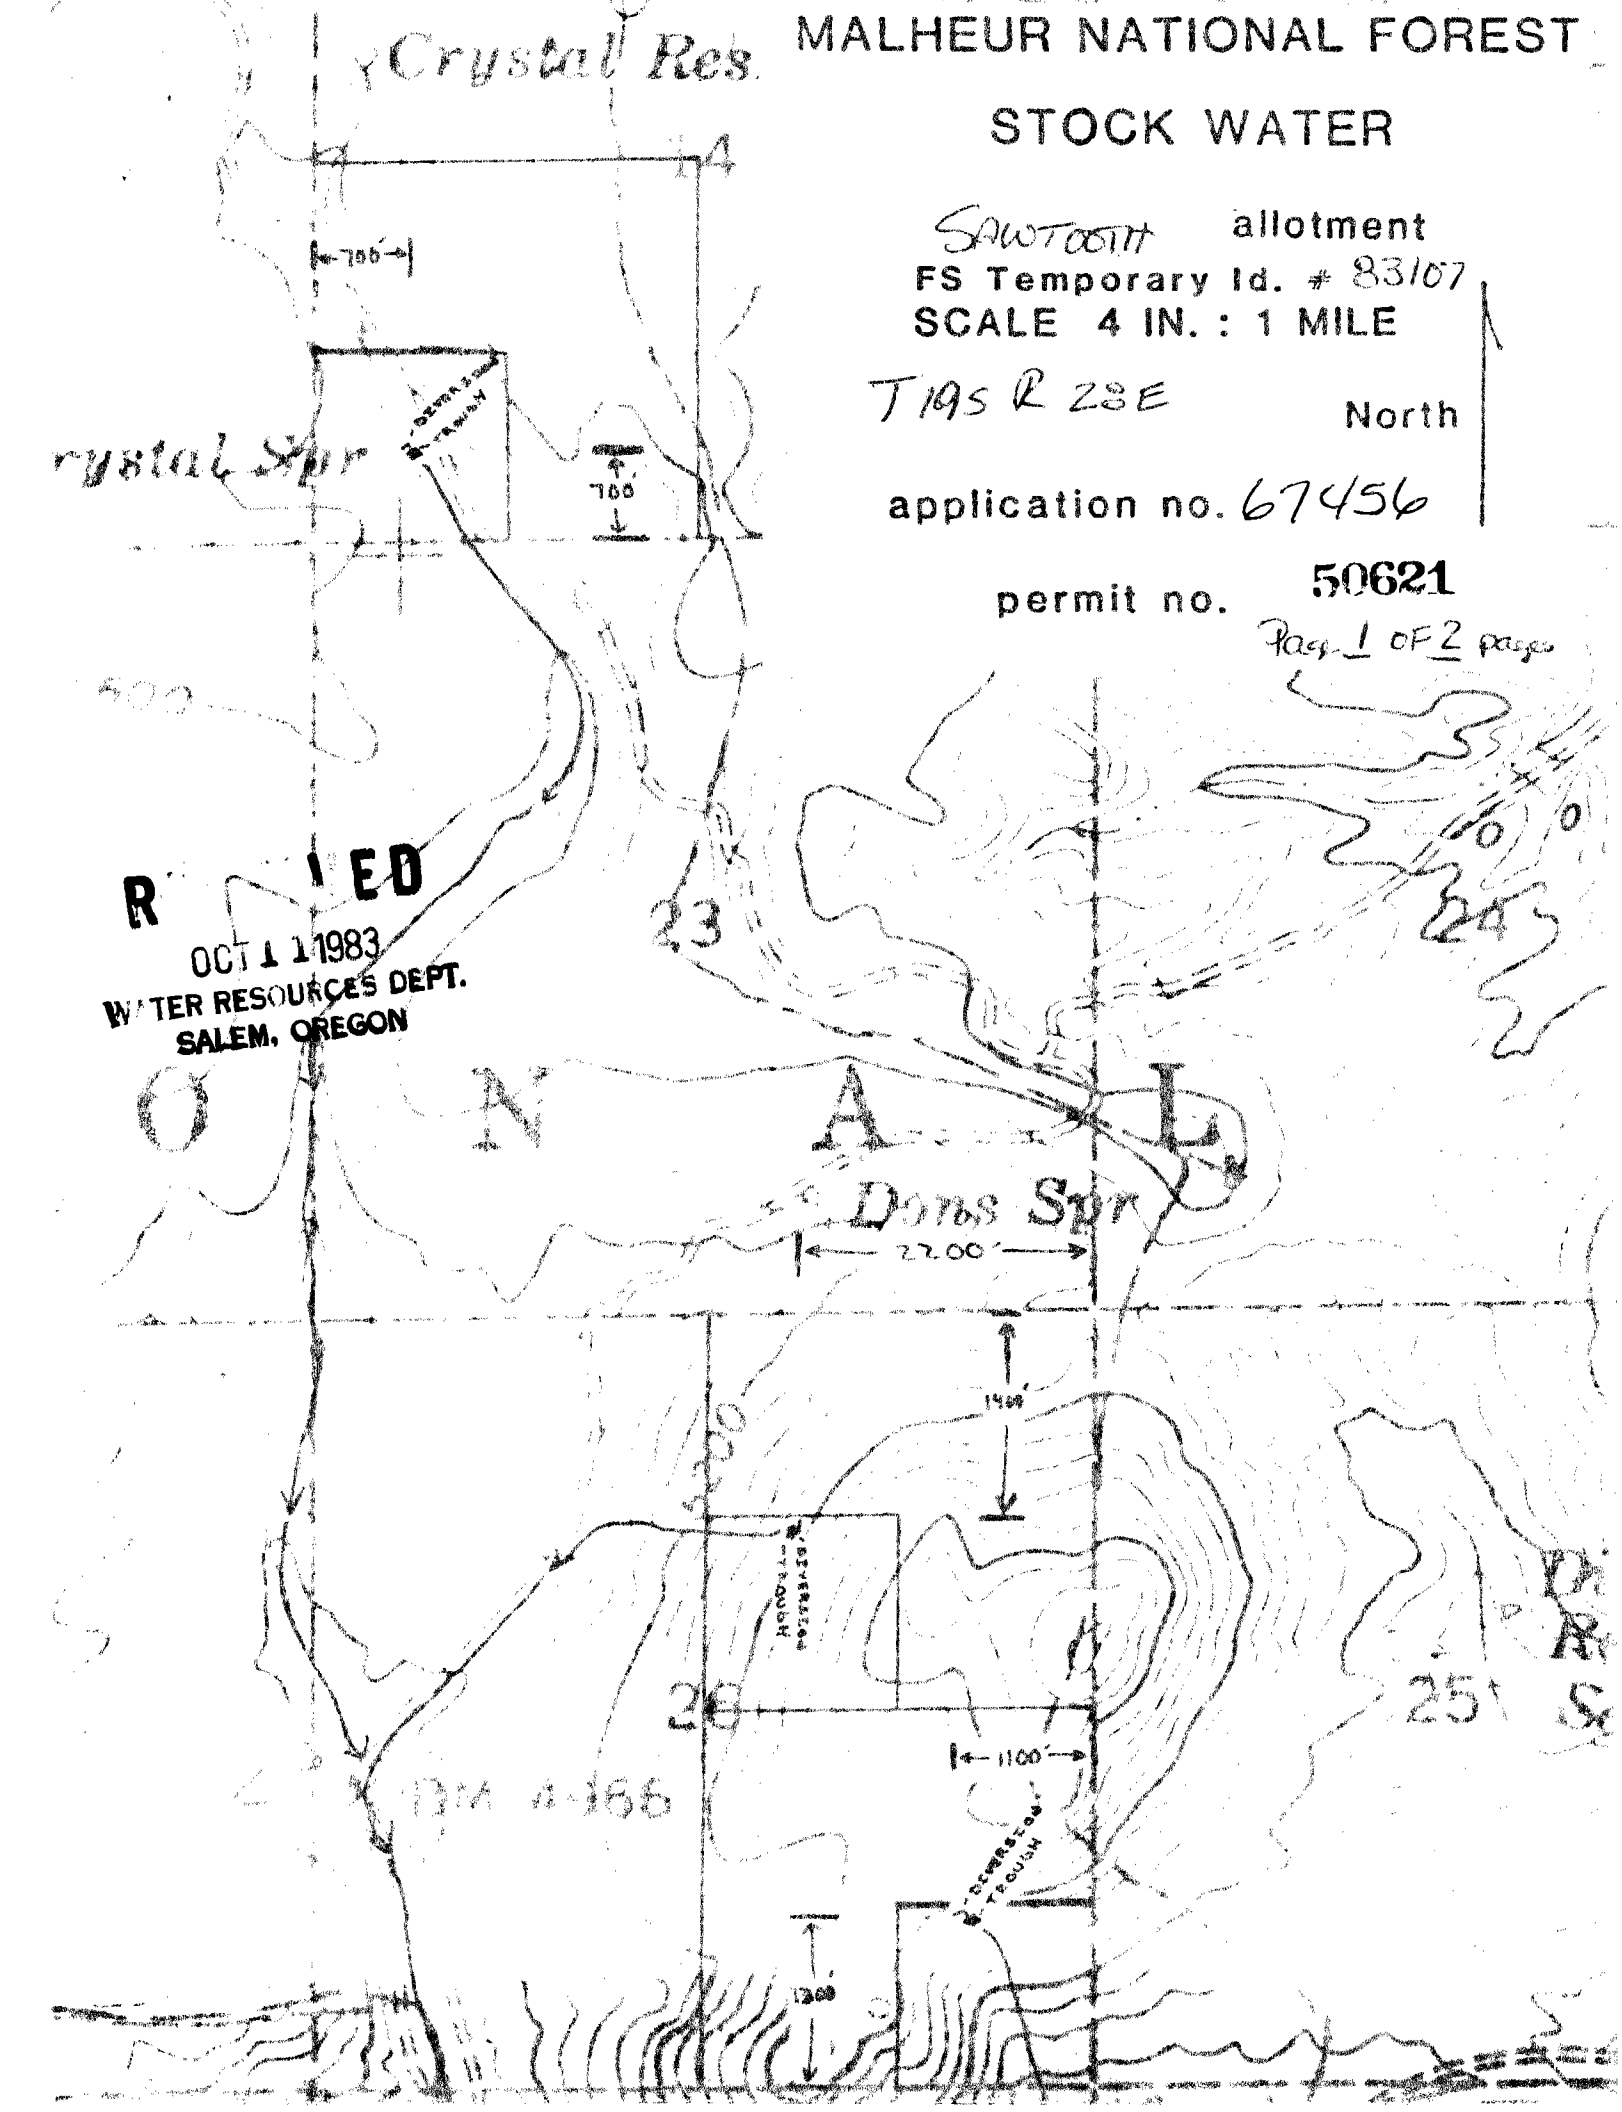
Crystal Res.
MALHEUR NATIONAL FOREST
STOCK WATER
SAWTOOTH allotment
FS Temporary Id. # 83107
SCALE 4 IN. : 1 MILE
T19S R 28E
North
application no. 67456
permit no. 50621
Page 1 OF 2 pages
Crystal Spr
700'
700'
RECEIVED
OCT 11 1983
WATER RESOURCES DEPT.
SALEM, OREGON
23
24
Dons Spr
2200'
1400'
DEVERSTON TROUGH
26
25
1100'
DEVERSTON TROUGH
1200'

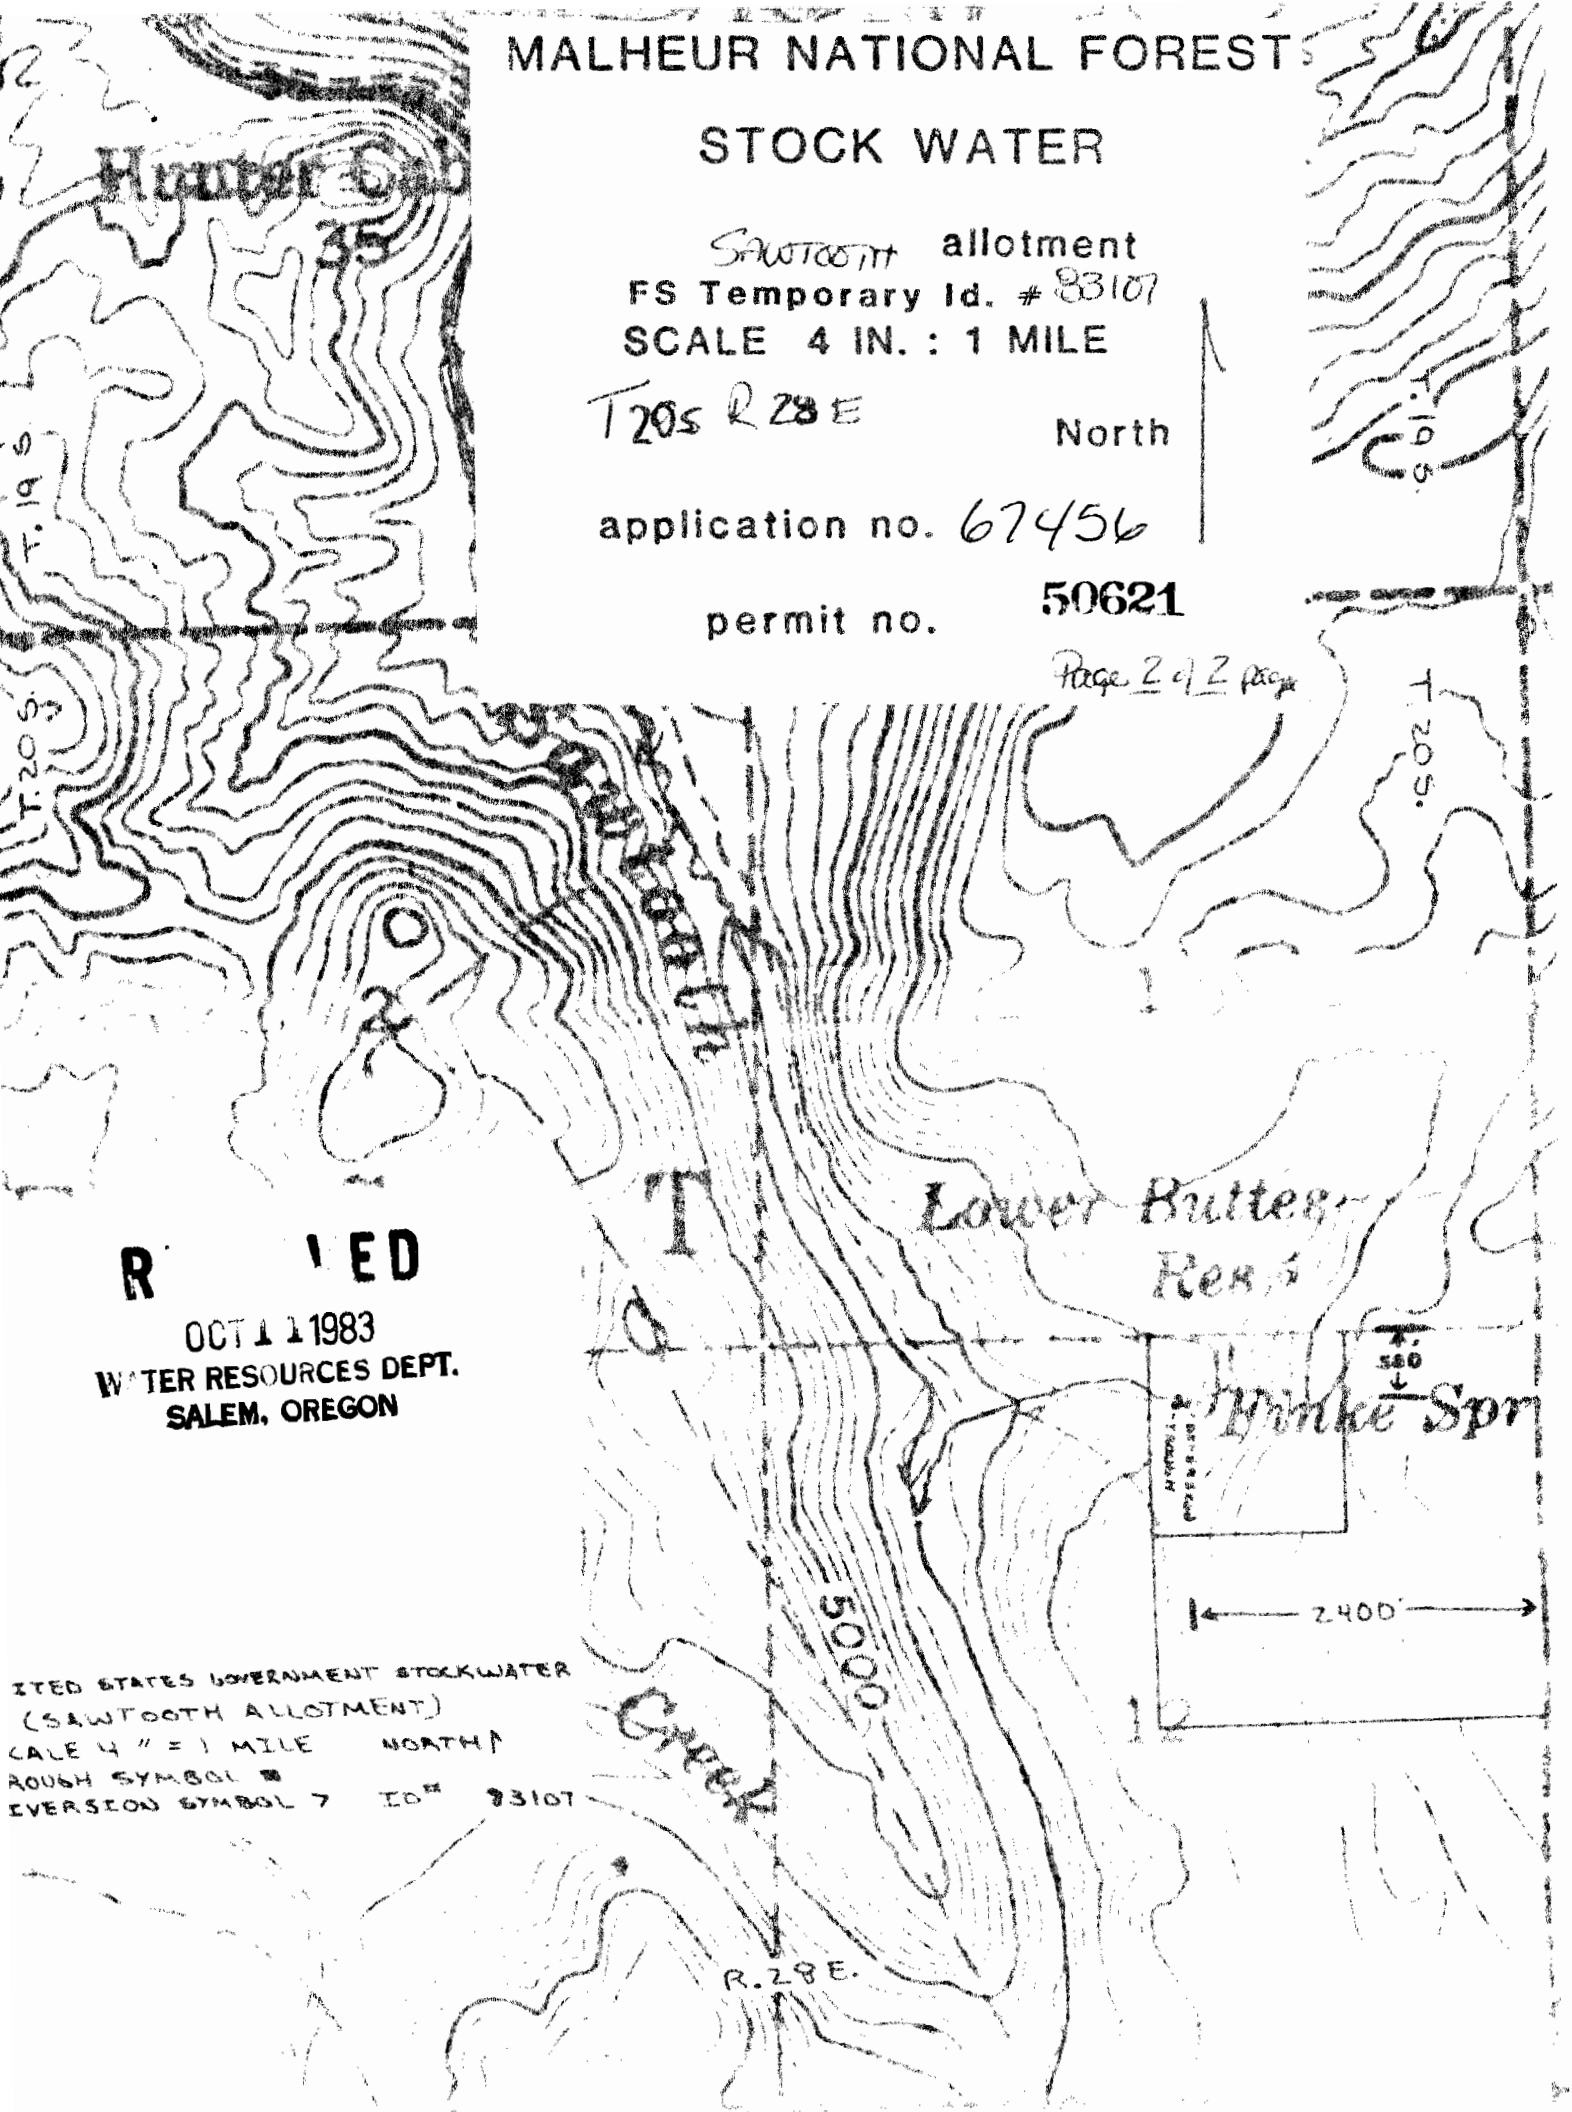
MALHEUR NATIONAL FOREST
STOCK WATER
SAWTOOTH allotment
FS Temporary Id. # 83107
SCALE 4 IN. : 1 MILE
T20S R28E
North
application no. 67456
permit no. 50621
Page 2 of 2 pages
Hunter Cab
35
T.19S.
T.20S.
Sawtooth
Lower Buttes Res
Finke Spr
580
2400
5000
Creek
R.28E.
R ED
OCT 1 1 1983
WATER RESOURCES DEPT.
SALEM, OREGON
ITED STATES GOVERNMENT STOCKWATER
(SAWTOOTH ALLOTMENT)
CALE 4 " = 1 MILE NORTH
ROUGH SYMBOL
IVERSION SYMBOL 7 ID# 83107