

MALHEUR NATIONAL FOREST


STOCK WATER
NORTH FORK allotment

FS Temporary Id. # 83P17
SCALE 4 IN. : 1 MILE

North ↑

application no. 67477

permit no. 50353

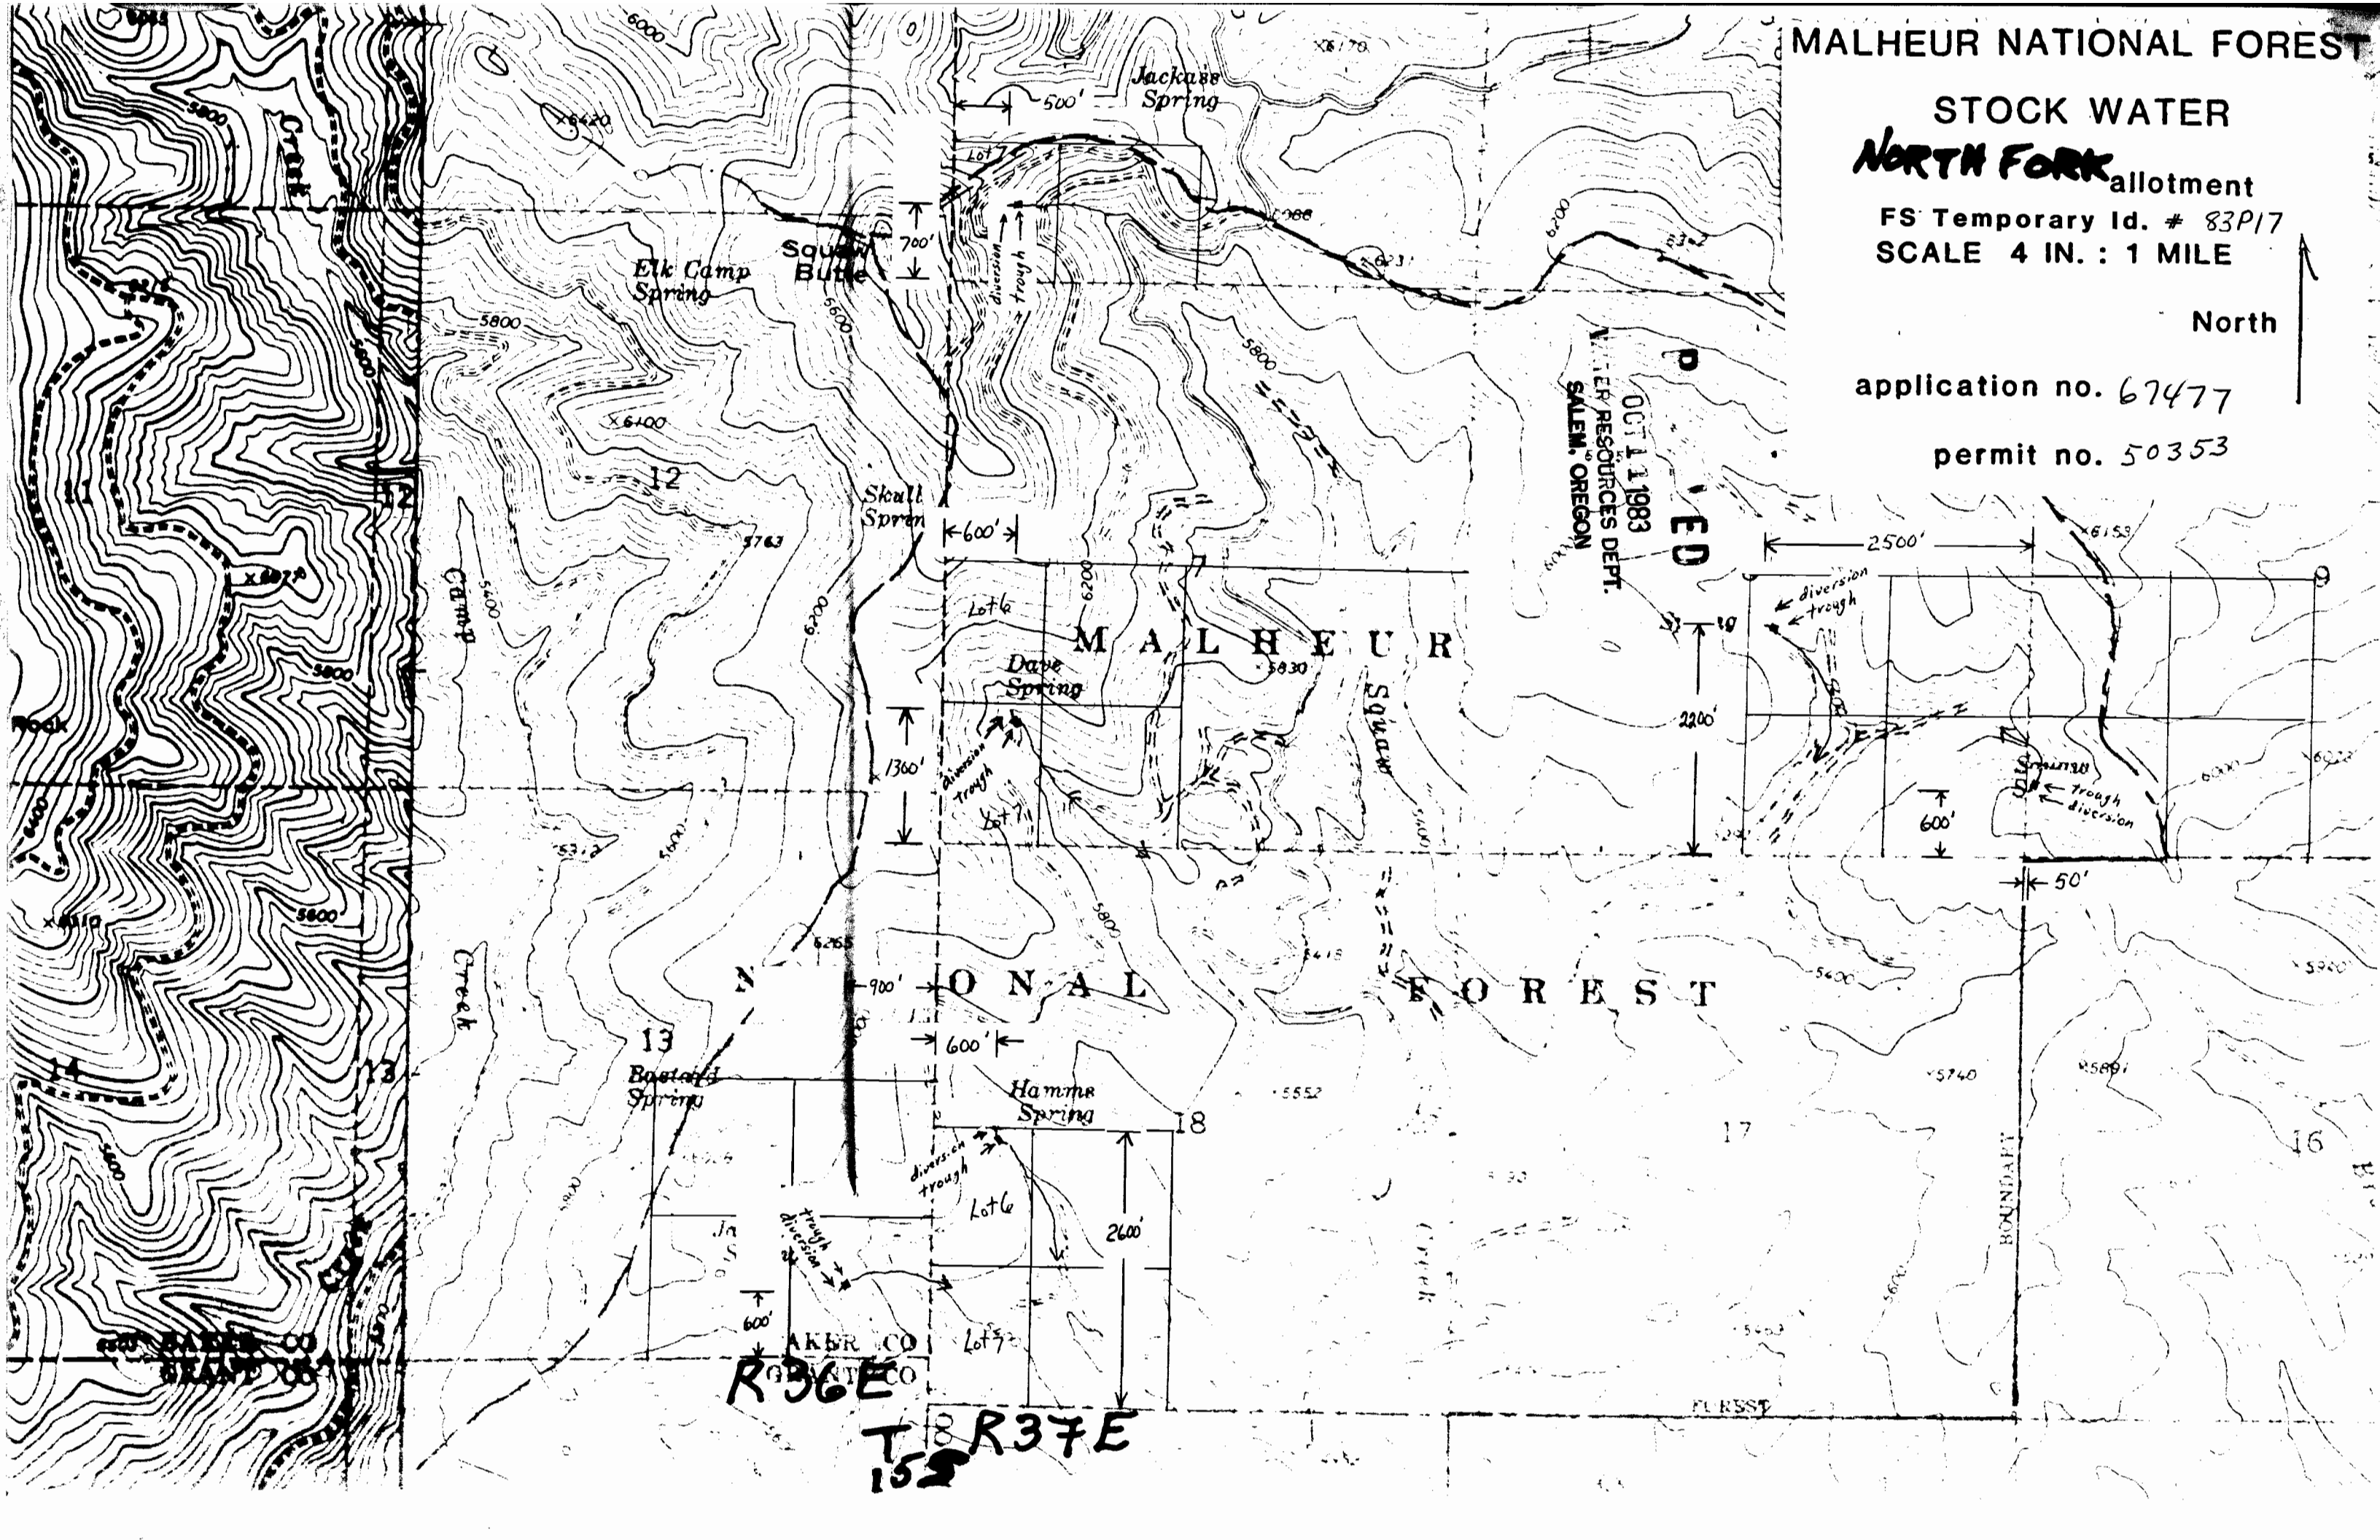

OCT 1 1983
SALEM, OREGON

AKER CO
T 8 R 37 E
15