

MALHEUR NATIONAL FOREST


STOCK WATER
NORTH FORK allotment

FS Temporary Id. #83P12
SCALE 4 IN. : 1 MILE

North

application no. 67472

permit no. 50350

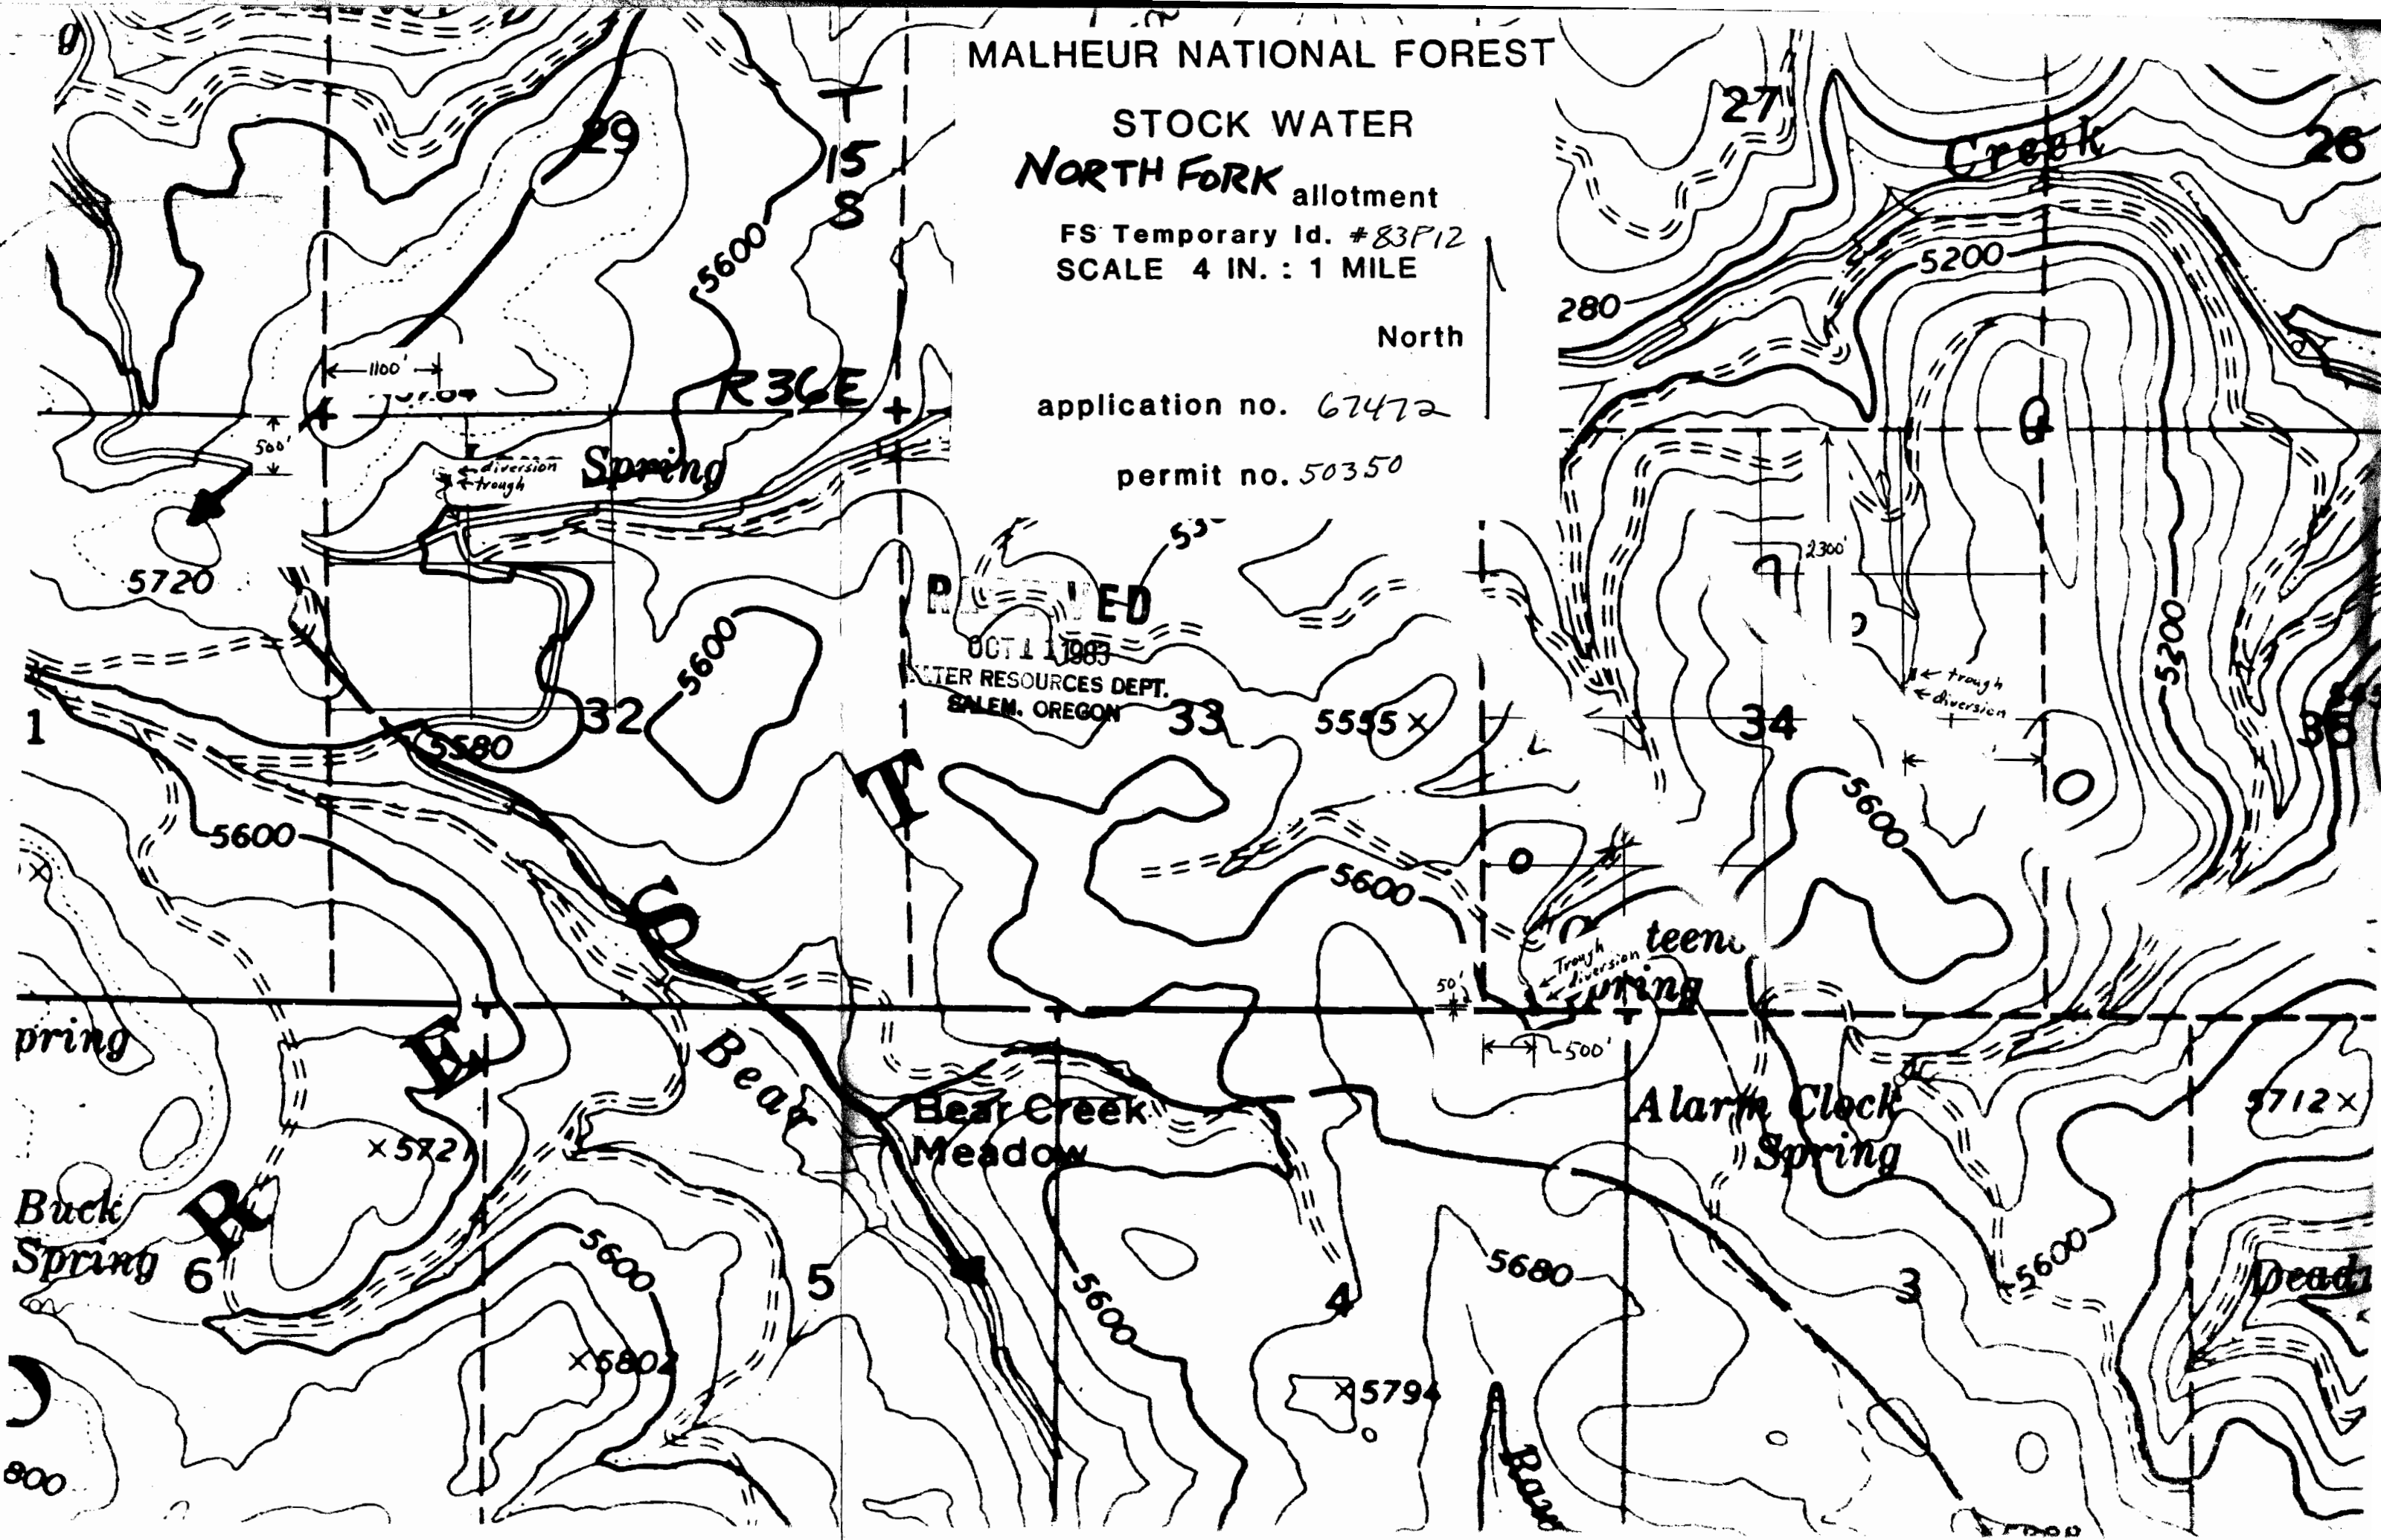


OCT 1 1983
WATER RESOURCES DEPT.
SALEM, OREGON

Bear Creek Meadow

Alarm Clock Spring

Buck Spring

Spring

teen Spring

Creek

Dead

800

5712x

5794

x572

x580

5555x

5720

1100'

500'

2300'

500'

T 15
R 8

27

28

1

32

33

34

6

5

4

3

8

28

5600

5600

5600

5600

5600

5600

5680

5600

5200

5200

5200

diversion
trough

trough
diversion

trough
diversion



































