


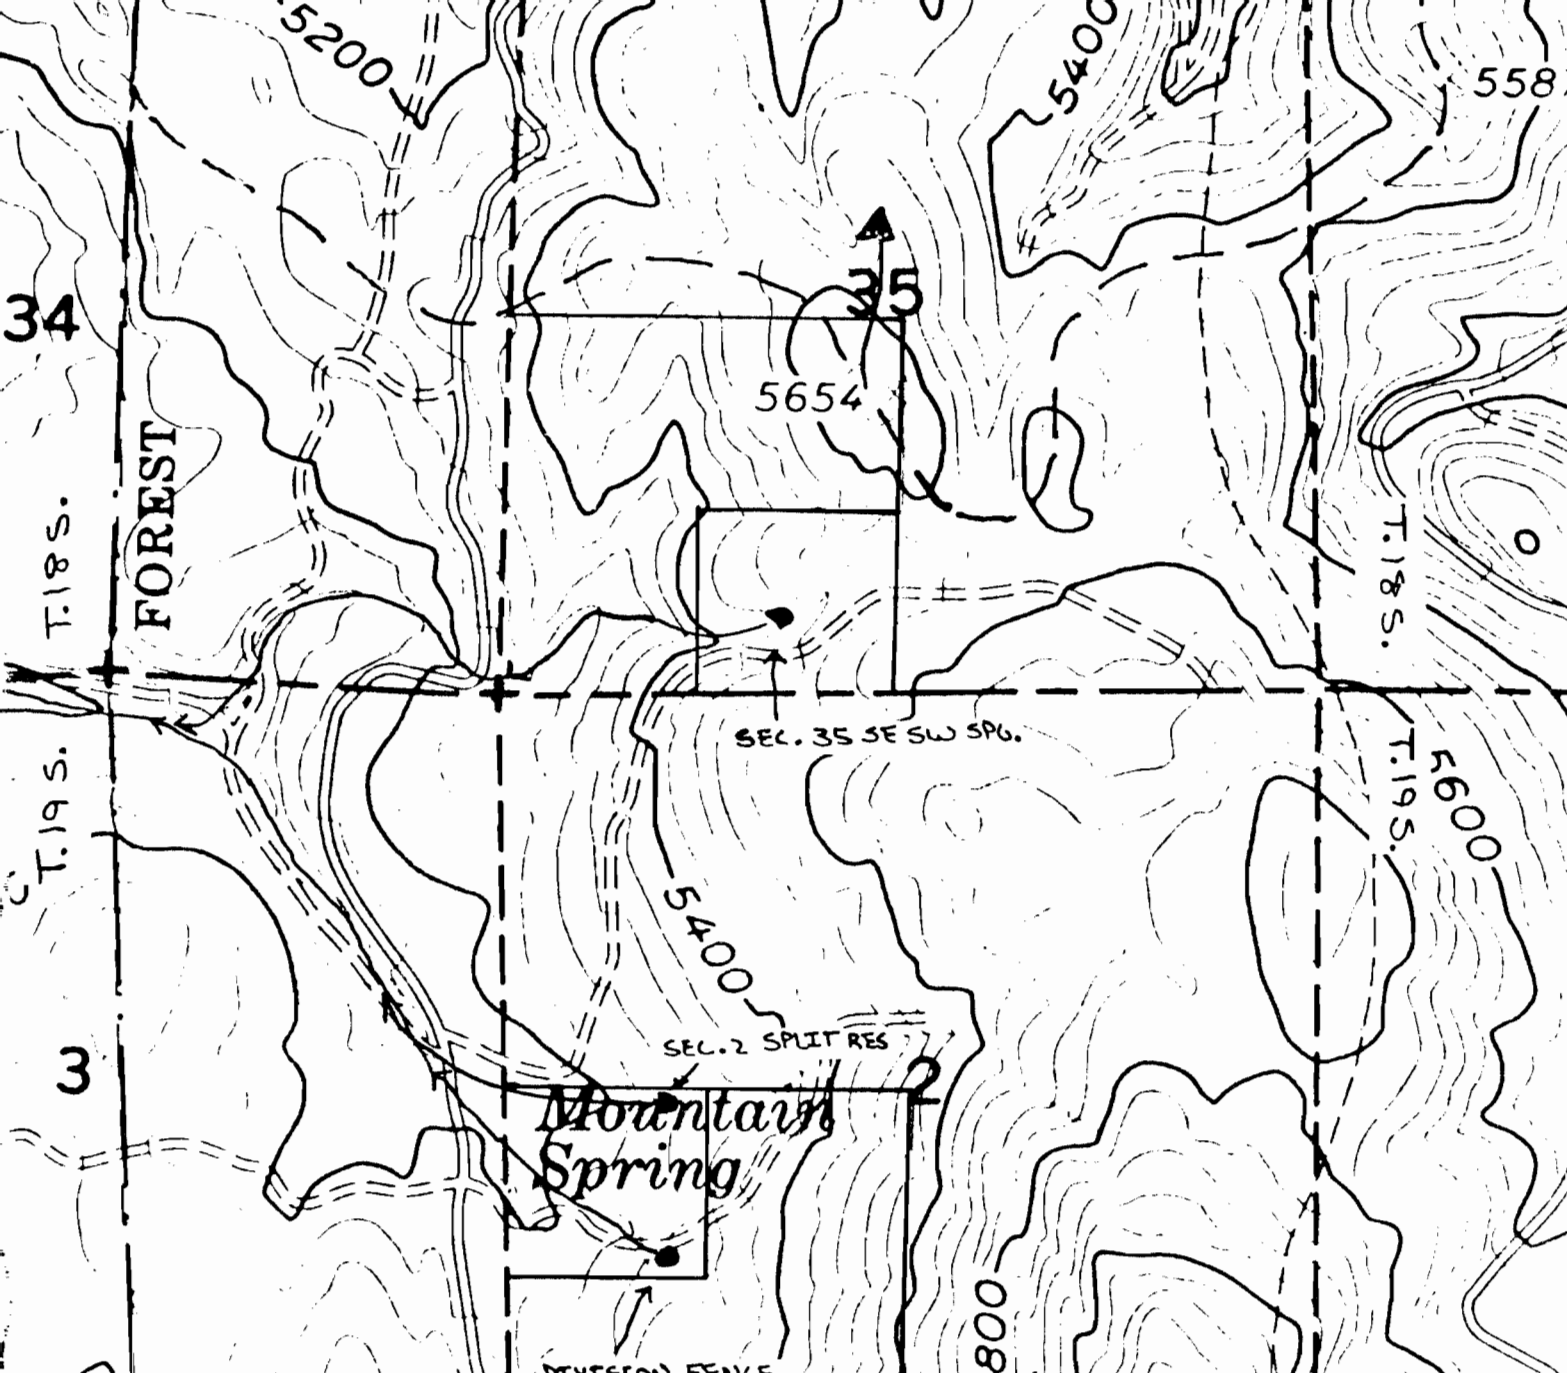

MALHEUR NATIONAL FOREST

STOCK WATER(R8330)

CALAMITY allotment

SCALE 4 IN. : 1 MILE

North↑

application no. R-65408

permit no. R10407

RECEIVED

WATER RESOURCES DEPT.  
SALEM, OREGON