


T. 37 S., R. 20 E., W.M.

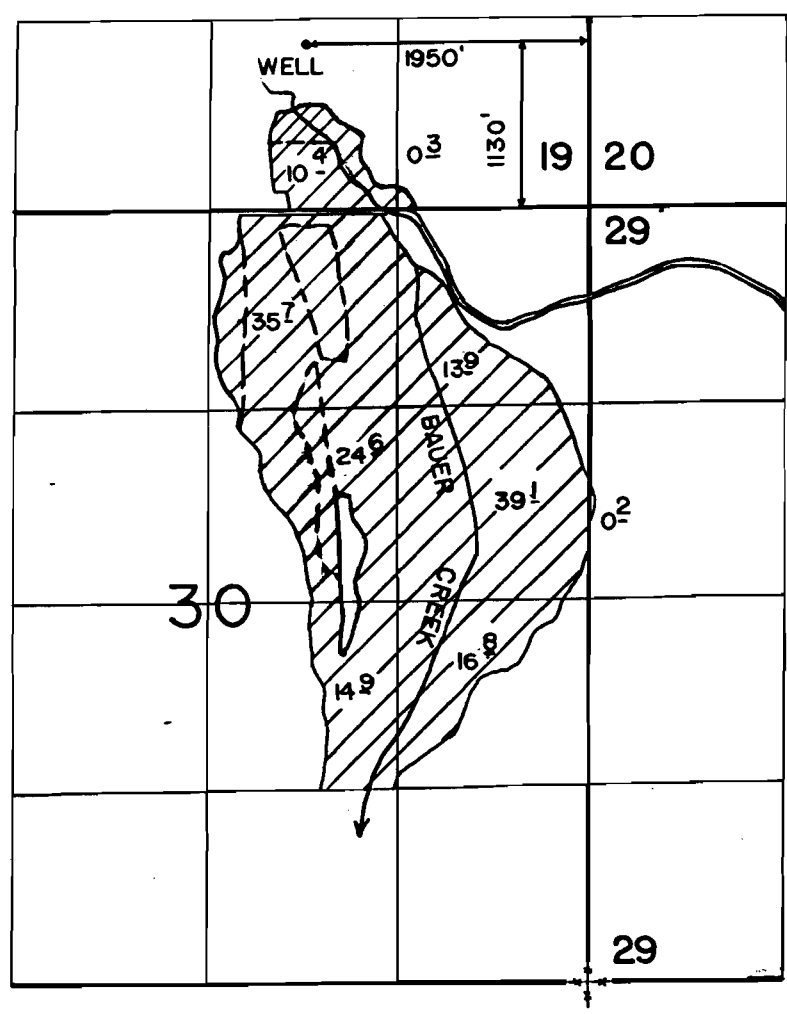

FINAL PROOF SURVEY
UNDER

Application No. G-10481 Permit No. G-9842 Cert # 67221
IN NAME OF

FRANCIS FREDERICK ALLEN

Surveyed AUG. 28. 1990., by B. W. BISHOP.

2-11-91 DSM
41037-379-76L