T. 31 S., R. 15 W., W. M.

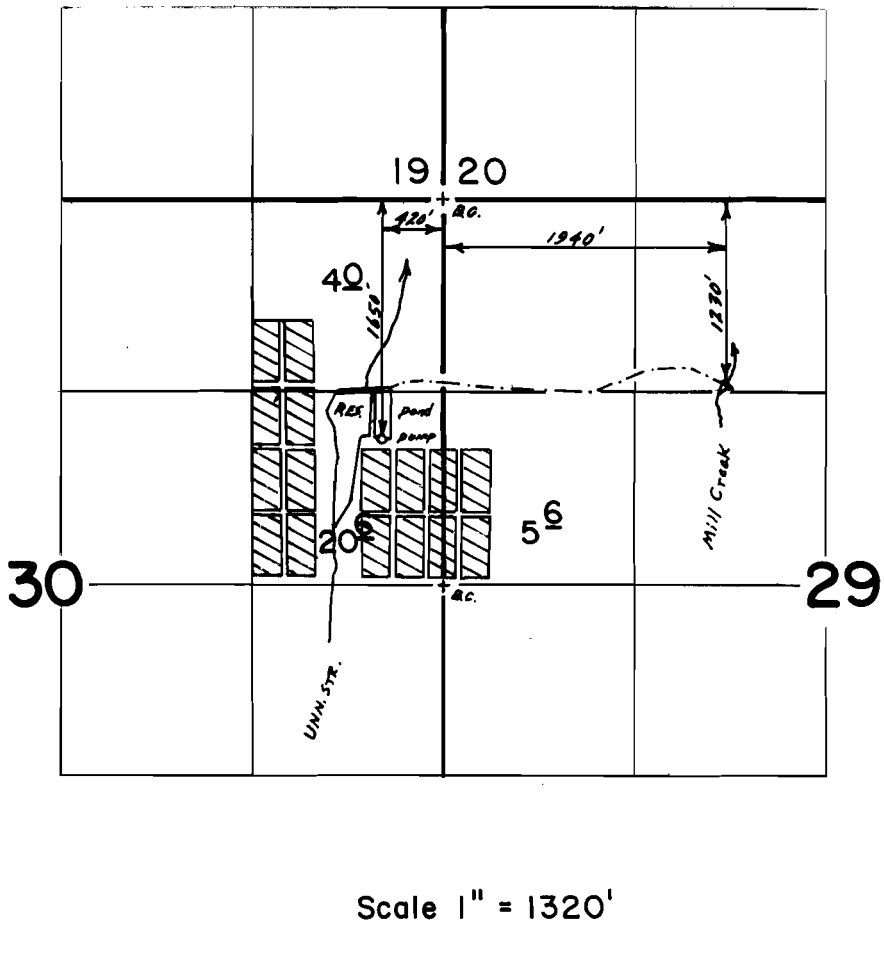

Scale 1" = 1320'

FINAL PROOF SURVEY
UNDER

Application No. 61901 **Permit No.** 46800
IN NAME OF

SEAWINDS FARMS, INC

Surveyed Sept. 15, 16 **19**90, **by** B.S. JAMES

PTS-& 41015-1344-142R

7/01 BSJ