


T.31S., R.15W., W.M.

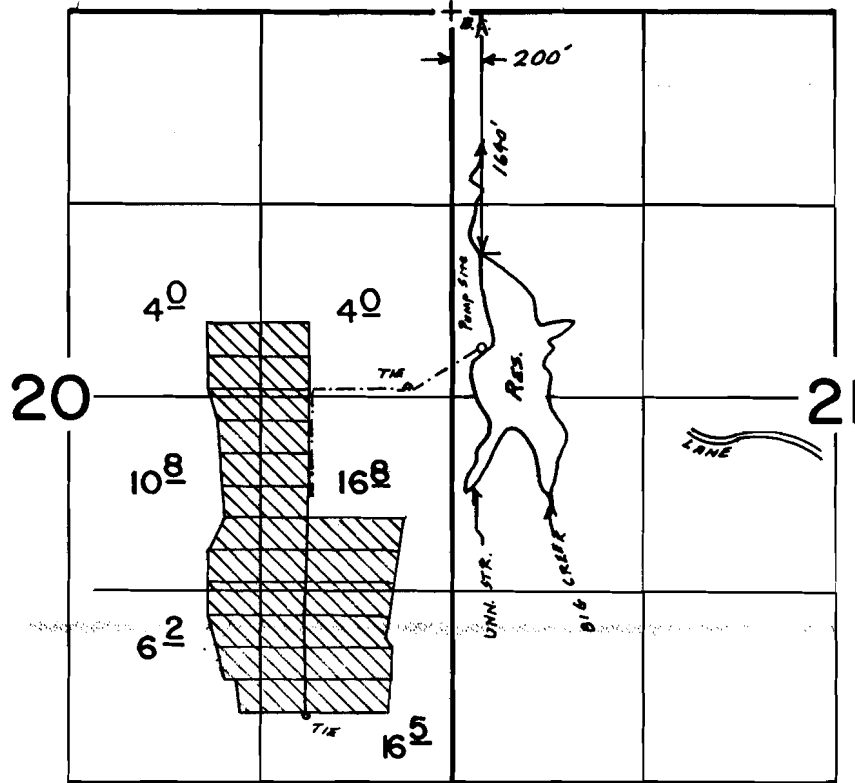

Scale 1" = 1320'

FINAL PROOF SURVEY
UNDER

R-63330 R-8449

Application No. 63324 Permit No. 46806...
IN NAME OF

SEAWINDS FARMS, INC.

Surveyed Sept. 15, 1990, by B.S. JAMES