


T2S, R4E, WM

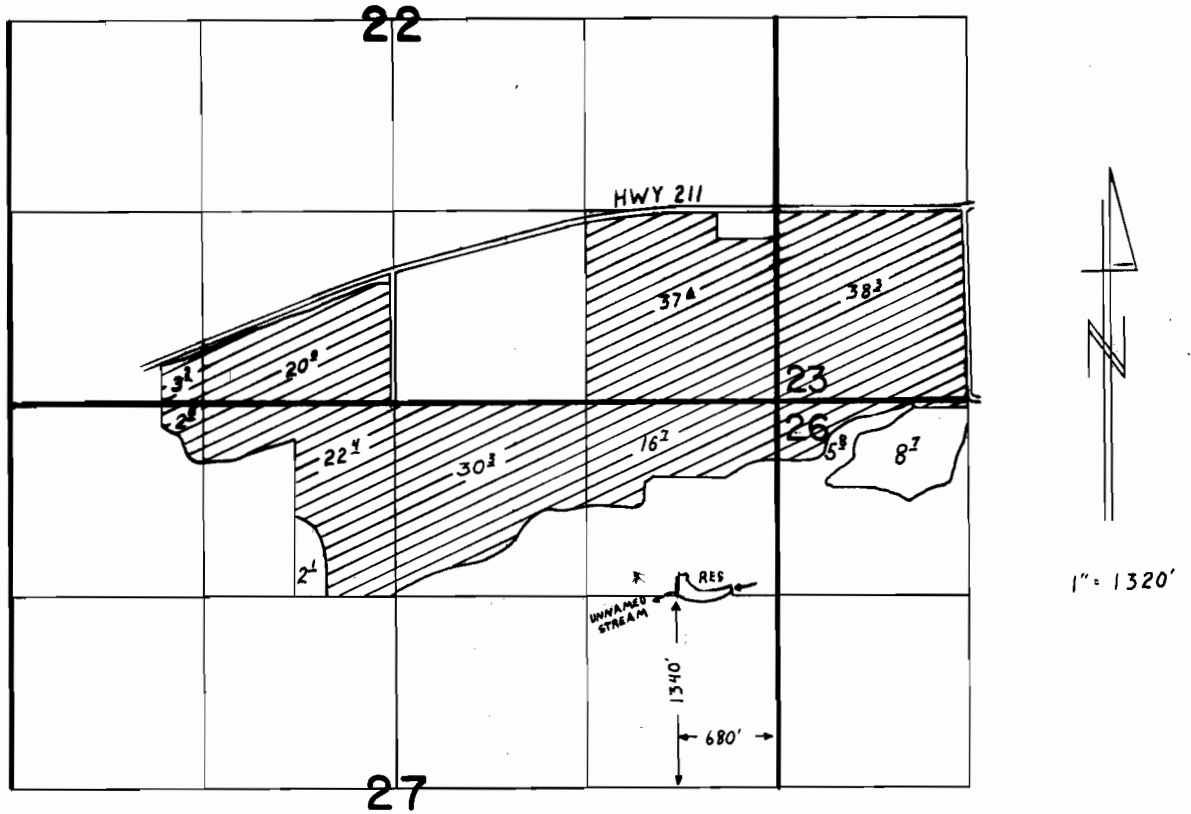

FINAL PROOF SURVEY UNDER

R-68004 R-9689
Application No. 68005 Permit No. 48424...
IN NAME OF

.....SANDY FARMS.....

Surveyed JUNE..17. 1987, by .T.M...WARREN....

RWK
DFK 1LL 248
PTS 1987 A