


SEC. 5, T.6S, R.1E, W. M.

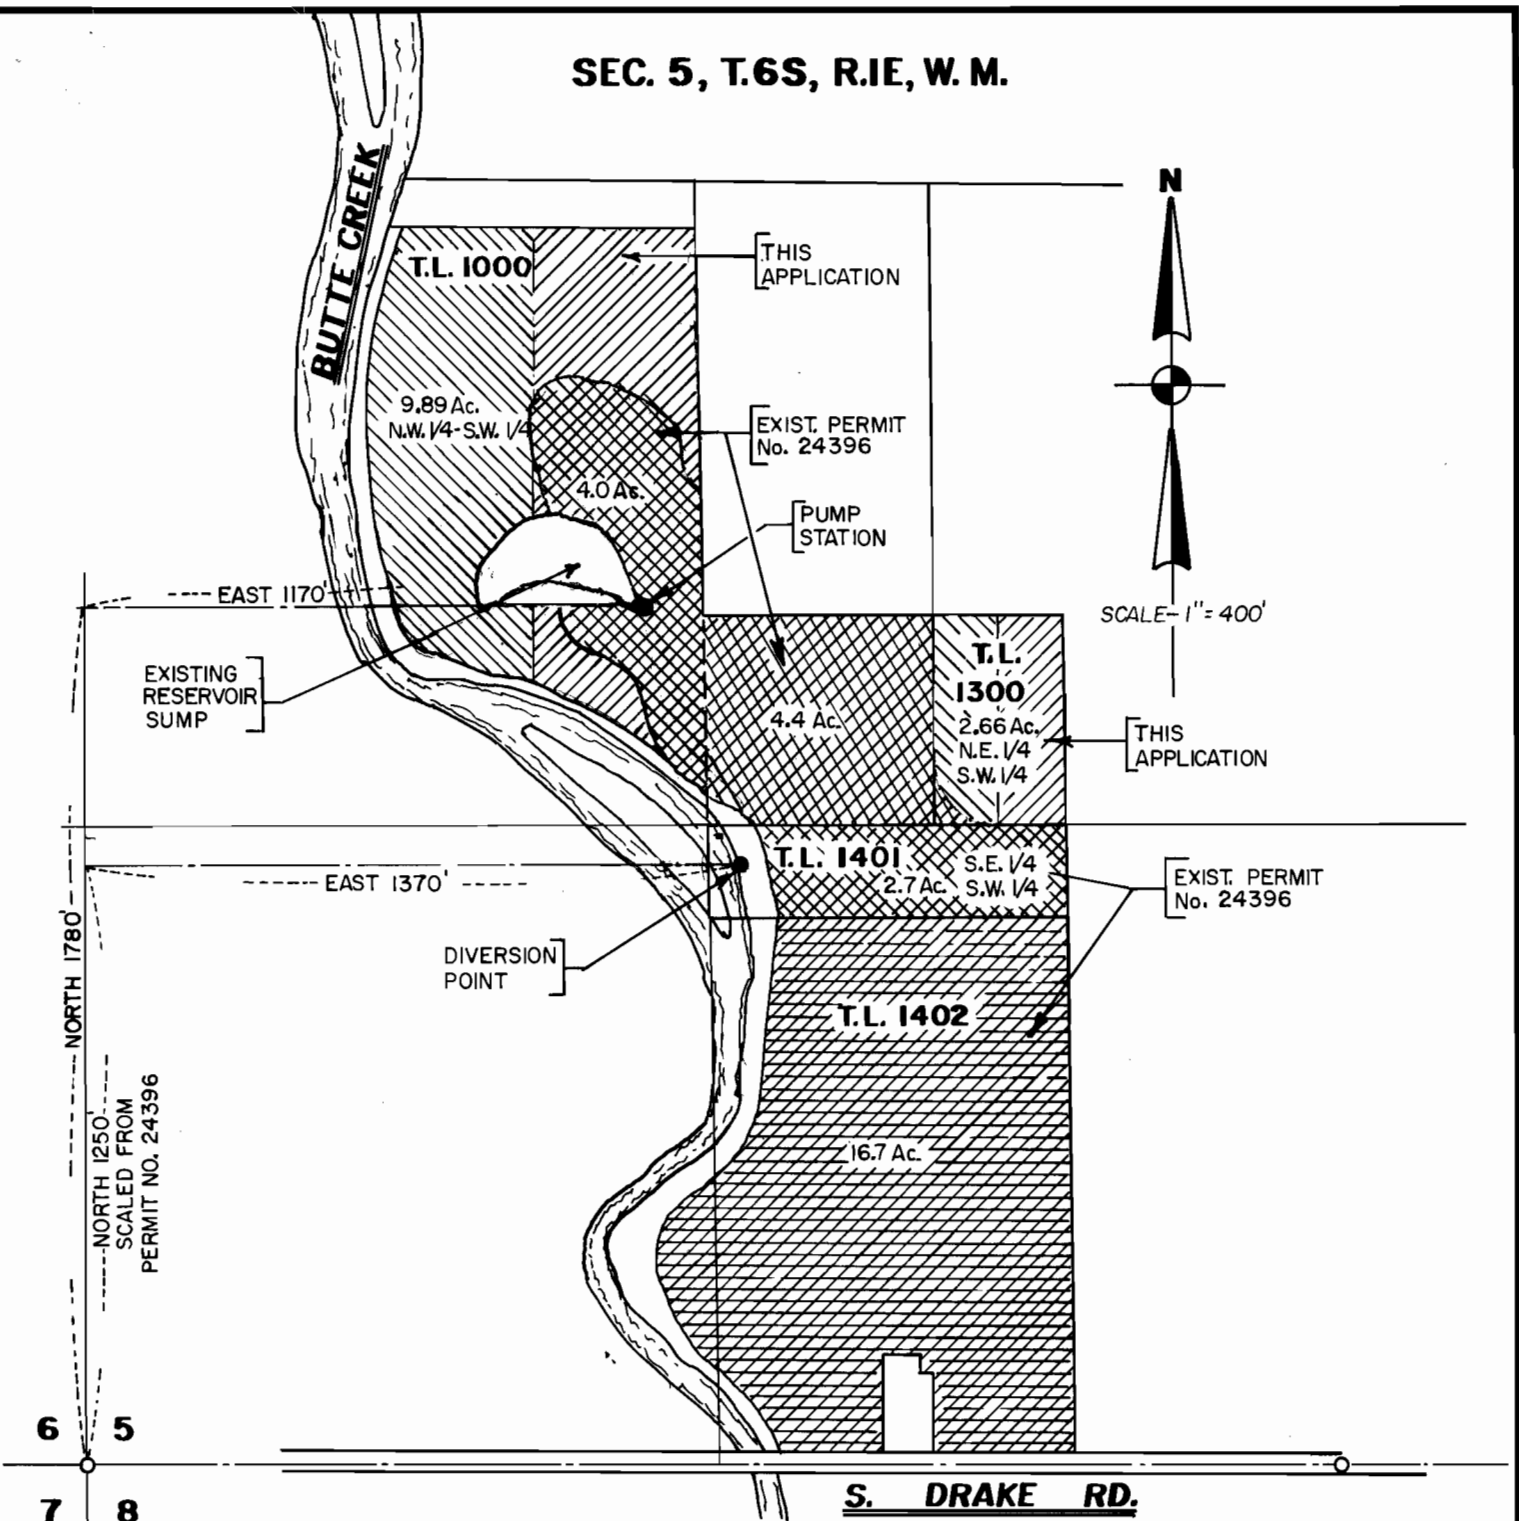

NOTE:

THIS MAP IS FOR THE PURPOSE OF IDENTIFYING THE LOCATIONS OF THE WATER RIGHT ONLY AND HAS NO INTENT TO PROVIDE DIMENSIONS OR LOCATION OF PROPERTY OWNERSHIP LINES.




FINAL PROOF SURVEY

IN NAME OF
ZINOVEI SHADRIN

APPLICATION NO. 68313
PERMIT NO. 49279

JUNE 26, 1990
REV. 8-9-91

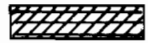LEGEND

-  ACREAGE NOT INCLUDED.
-  ACREAGE TO RECEIVE SUPPLEMENTAL SUPPLY FROM RESERVOIR.
-  ACREAGE TO RECEIVE SUPPLY FROM BOTH BUTTE CREEK AND RESERVOIR.

Ronald A. Tatone



ZAROSINSKI - TATONE ENGINEERS, INC.

3737 S. E. 8TH AVENUE, PORTLAND, OREGON 97202

PHONE: (503) 235-8795