


T2N, R10W, WM

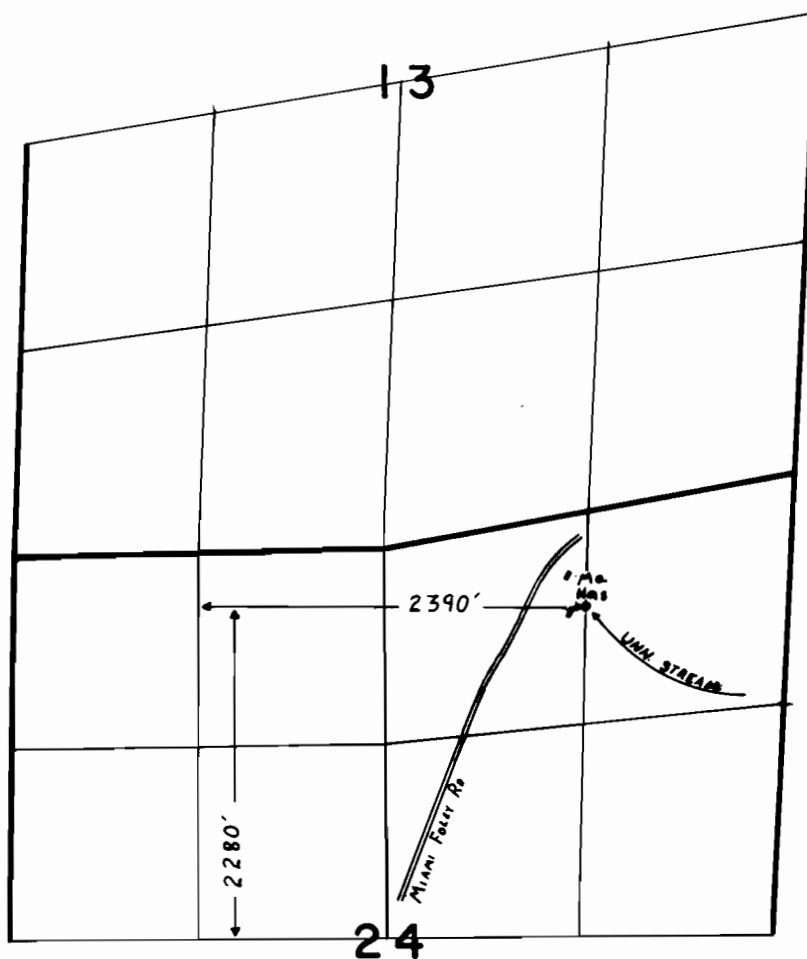

**FINAL PROOF SURVEY**  
UNDER

Application No. 59484... Permit No. 447.23.....  
IN NAME OF

.....TERRY & RICK KJEMPERUD.....

Surveyed JULY...8... 19.8.7, by J.M. WARREN.....