


T. 1 S. R. 2 W. W. M.

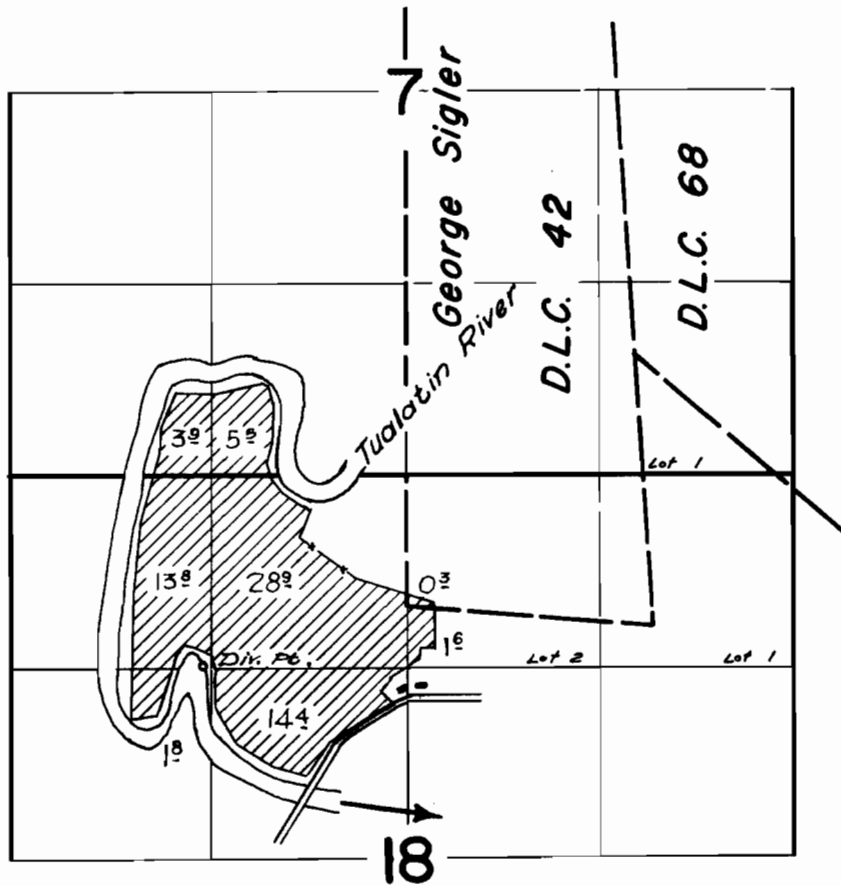

FINAL PROOF SURVEY UNDER

Application No. 21837.... Permit No. 17175....
IN NAME OF

VICTOR S. MADSEN

Surveyed July 12, 1951., by H. L. Coffman