

Map of The G. M. Hartwell Pipe

I, E. H. Kern, of Coquille Coos Co. Ore. do hereby certify that this map was made from notes taken taken during an actual survey made by me on the 7<sup>th</sup> day of Jan. 1926 and that it correctly represents the work described in the accompanying application.

E. H. Kern

Registered Professional Engineer

Ore. License # 843

Dec. 31-1919.

Field Notes.

Began at Spring from which the S<sup>1</sup>/<sub>4</sub> cor. Sec. 8 bears S 11° 15' E. 1922 ft., thence N 43° 30' W 80 ft to Ram - W 115 ft - S 41° 52' W 200 ft. To Tank.  
Pipe line = 395 ft. 2" Dia


Line Located in the NE<sup>1</sup>/<sub>4</sub> SW<sup>1</sup>/<sub>4</sub> Sec. 8.  
Twp 28 S - R. 13 W. W. Merd.

Coos Co. Oregon.

Scale 1" = 200 ft.

Mag. var. N 20° E Jan 7. 1926. 27m.

NE<sup>1</sup>/<sub>4</sub>  
SW<sup>1</sup>/<sub>4</sub>  
Sec. 8.

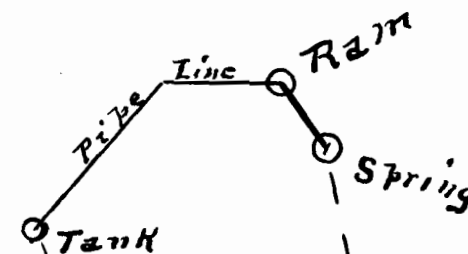

SE<sup>1</sup>/<sub>4</sub>  
SW<sup>1</sup>/<sub>4</sub>  
Sec. 8.

N 43° 30' W  
80 ft  
W 115 ft  
S 41° 52' W  
200 ft

Application No. 10560  
Permit No. 7143

S<sup>1</sup>/<sub>4</sub> cor.