


G8186
67248
58352

T. 3 S. R. 30 E. W.M.

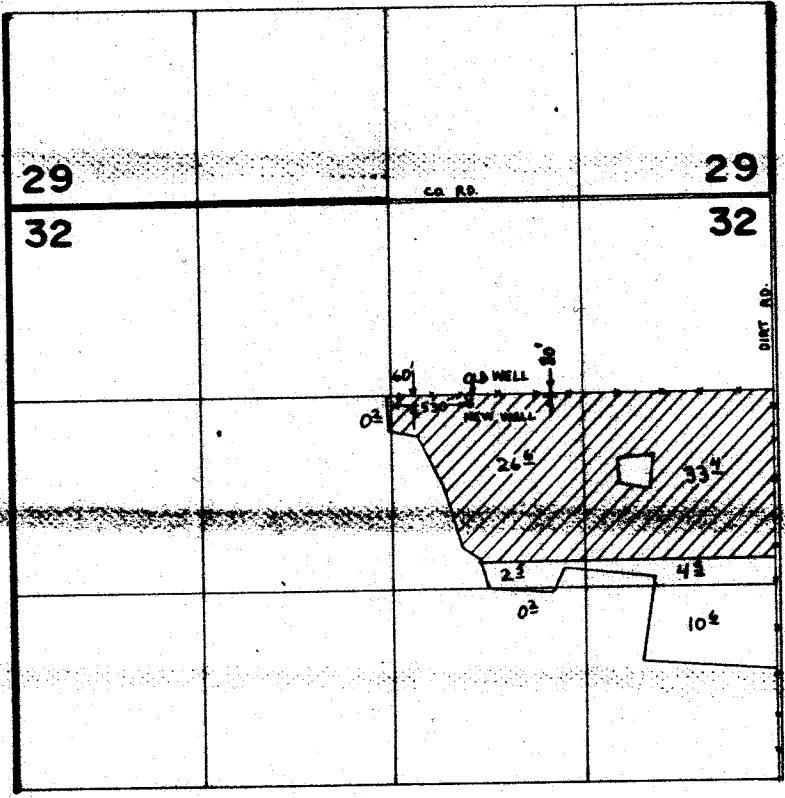

Scale 1" = 1320'



FINAL PROOF SURVEY UNDER

Application No. G.8812. Permit No. G.8186.....
IN NAME OF

.....**CON. DOHERTY**.....

Surveyed March. 31. 1987., by V. Church.....