
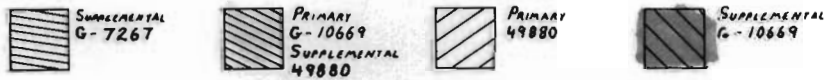
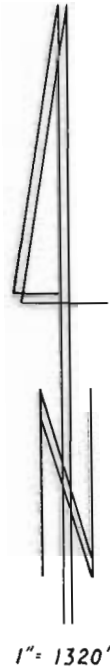


# T. 5 S., R. 1 W., W.M.

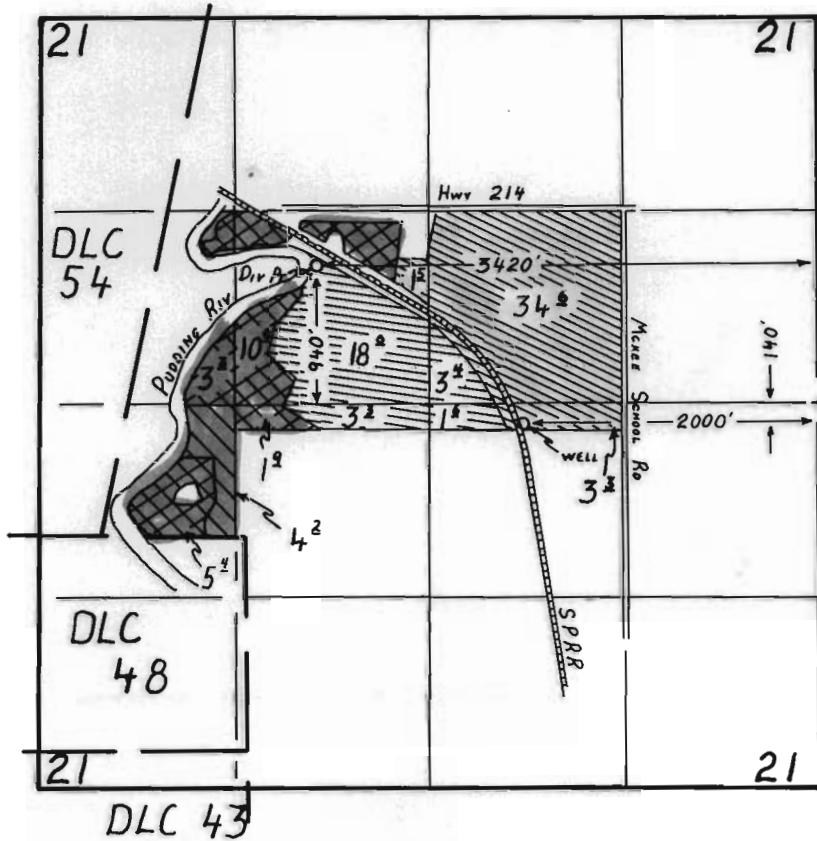

## FINAL PROOF SURVEY

UNDER

Application No. G-7709\*, G-11584 & 68865 Permit No. G-7267\*, G-10669 & 49880  
IN NAME OF

Carl I. Vistica

Surveyed May 25, 1990\* & Feb. 21, 1991, by T.M. Warren\* & R.W. Klassen