
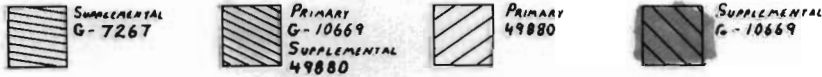


T. 5 S., R. 1 W., W.M.

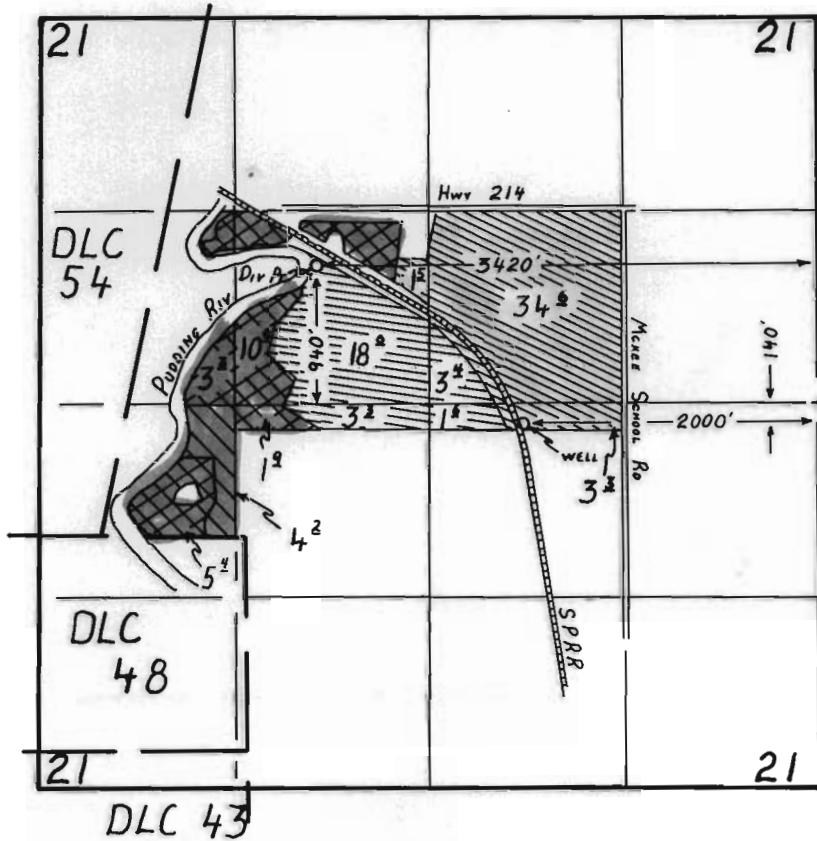

FINAL PROOF SURVEY

UNDER

Application No. G-7709*, G-11584 & 68865 Permit No. G-7267*, G-10669 & 49880
IN NAME OF

Carl I. Vistica

Surveyed May 25, 1990* & Feb. 21, 1991, by T.M. Warren* & R.W. Klassen