


NE 1/4 OF SE 1/4 OF SECTION 32
T1S, R4E, WM
CLACKAMAS COUNTY, OREGON

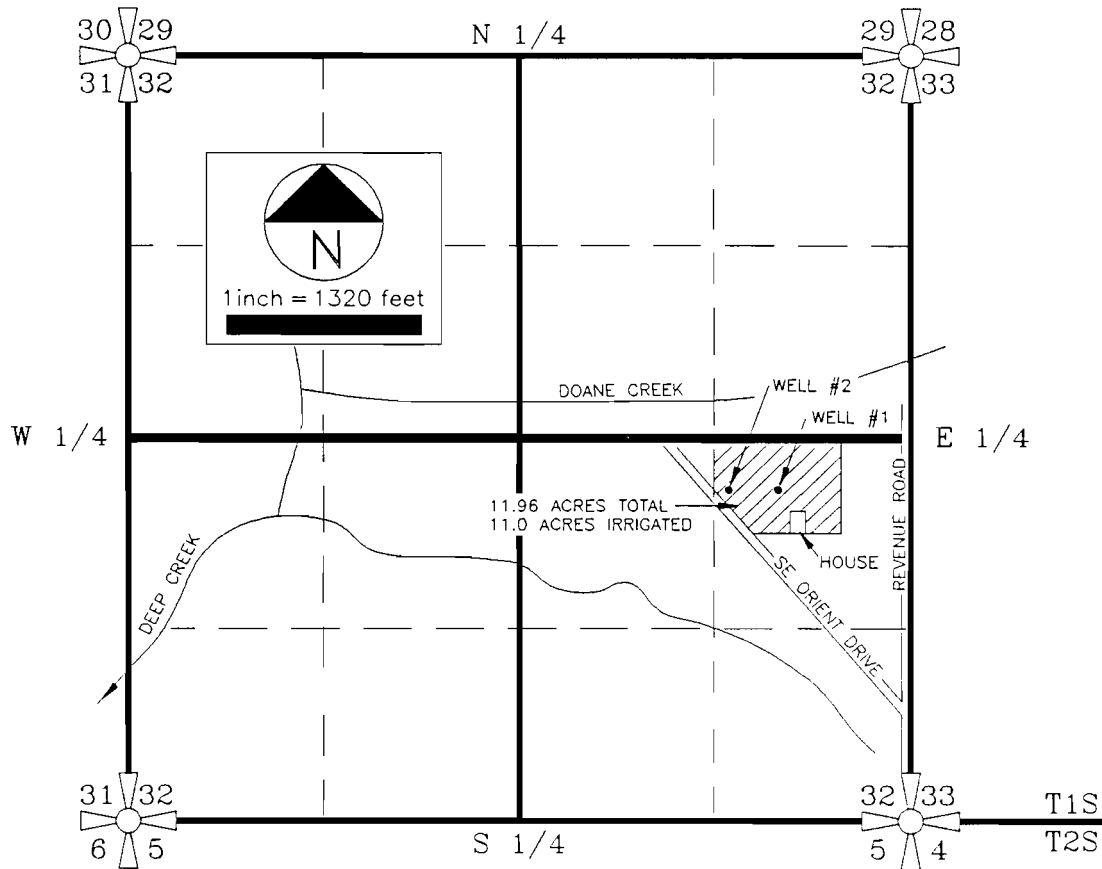


THE PREPARATION OF THE MAP WAS FOR THE PURPOSE OF IDENTIFYING THE LOCATION OF THE WATER RIGHT ONLY AND HAS NO INTENT TO PROVIDE DIMENSIONS OR LOCATION OF PROPERTY OWNERSHIP LINES.

WELL #1 IS LOCATED 357 FEET SOUTH AND 883 FEET WEST FROM THE NORTHEAST CORNER OF THE NE 1/4 OF THE SE 1/4 OF SECTION 32.

WELL #2 IS LOCATED 357 FEET SOUTH AND 1215 FEET WEST FROM THE NORTHEAST CORNER OF THE NE 1/4 OF THE SE 1/4 OF SECTION 32.

SURVEYED SEPTEMBER 1990
BY SUZANNE T. CRANE, CWRE

REVISED JAN 9, 1991

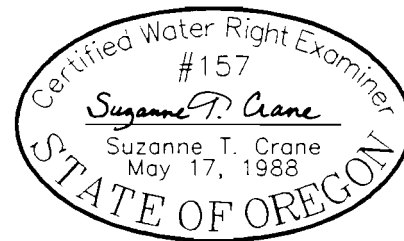

FINAL PROOF SURVEY MAP

PREPARED BY SUZANNE T. CRANE, CWRE

DATE
OCT 1990

PROJECT NO.



Suzanne Crane Engineering
13755 SE 119TH DRIVE
CLACKAMAS, OR 97015
(503) 789-1983

APPLICATION FOR PERMIT NUMBER G-11744
AND PERMIT NO. G-10843
to appropriate ground water in the name of:

STANLEY & SON'S NURSERY

FIGURE

1