


T.32S. R.15W. W.M.

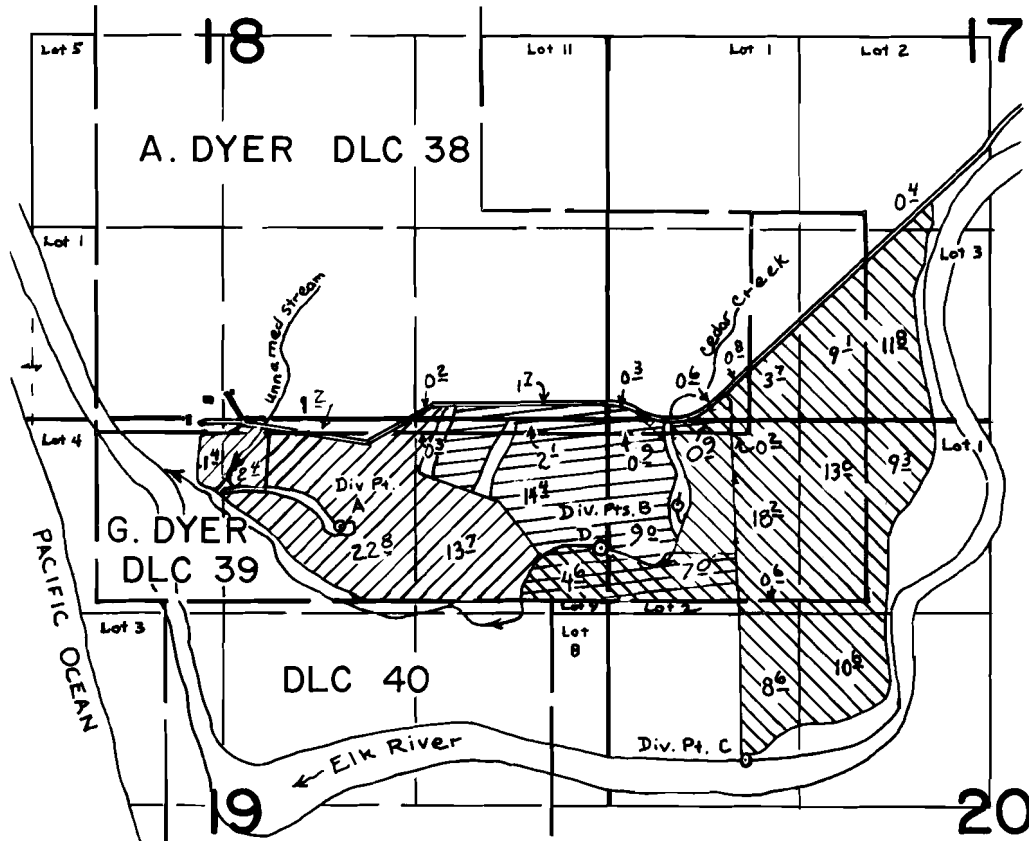

Div. Pts. Located:

A- 740'S & 1850'W

B- 580'S & 480'E

C- 2350'S & 950'E

D- 890'S & 50'W

all from NW cor. of Sec. 20

SCALE: 4" = 1 mile

-  unnamed stream
-  Cedar Creek
-  Elk River

**FINAL PROOF SURVEY**  
UNDER

Application No. 45509 Permit No. 33963  
IN NAME OF

**ROBERT G. & BEVERLY MCKENZIE**

JUNE 28, 1988 B. S. JAMES

Surveyed June 26, 1979, by S. Donaldson...

Sept. 24, 1991, by B.S. James

REV. JUNE 30, 1988 JK  
32S 15W NW & SW photos

RAS/10/91/BJ