


T. 21 S., R. 5 W. W.M.

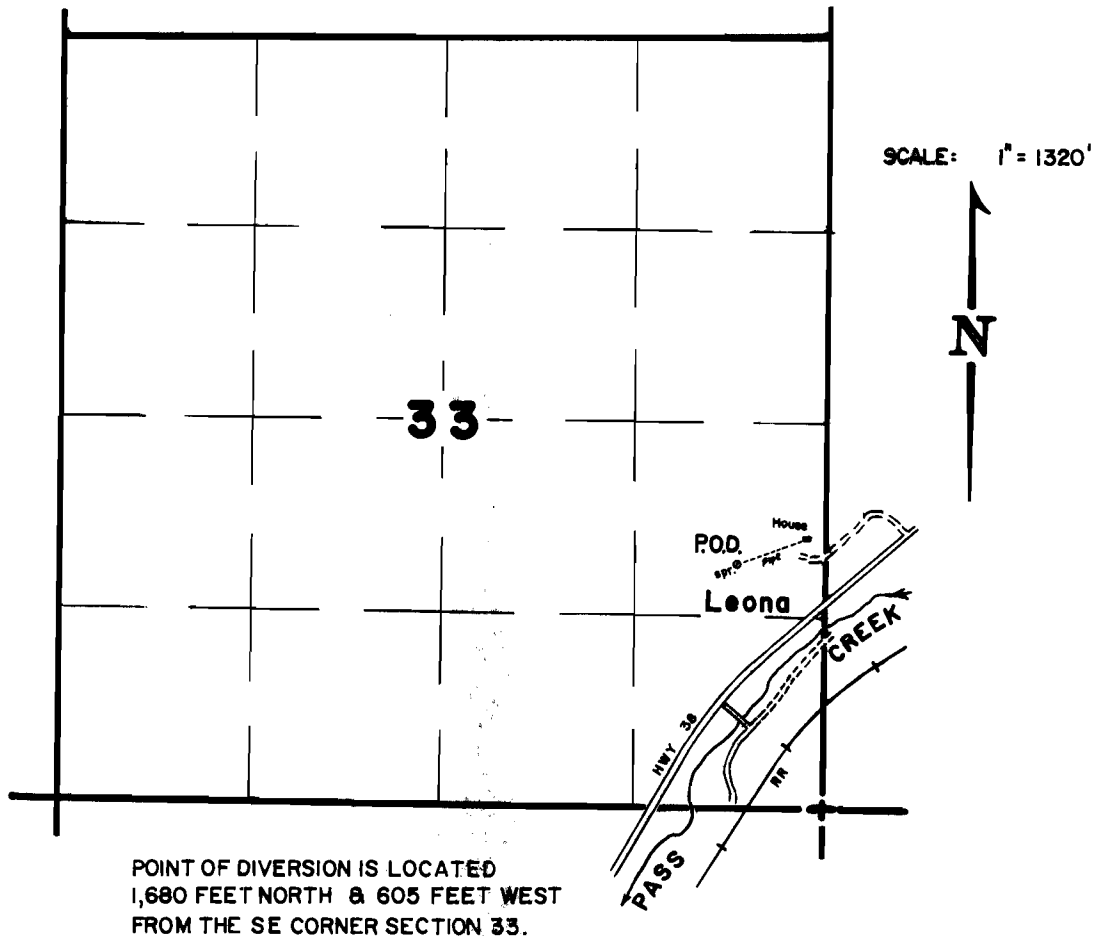

**FINAL PROOF SURVEY
UNDER**

Application No. 56073. Permit No. 42284.....
IN NAME OF

...GLENN V. and SHERRILL BICKFORD.....

Surveyed Sept. 13 1990, by B. SUE JAMES.