


T. 28 S., R. 7 W., W.M.
SECTION 10

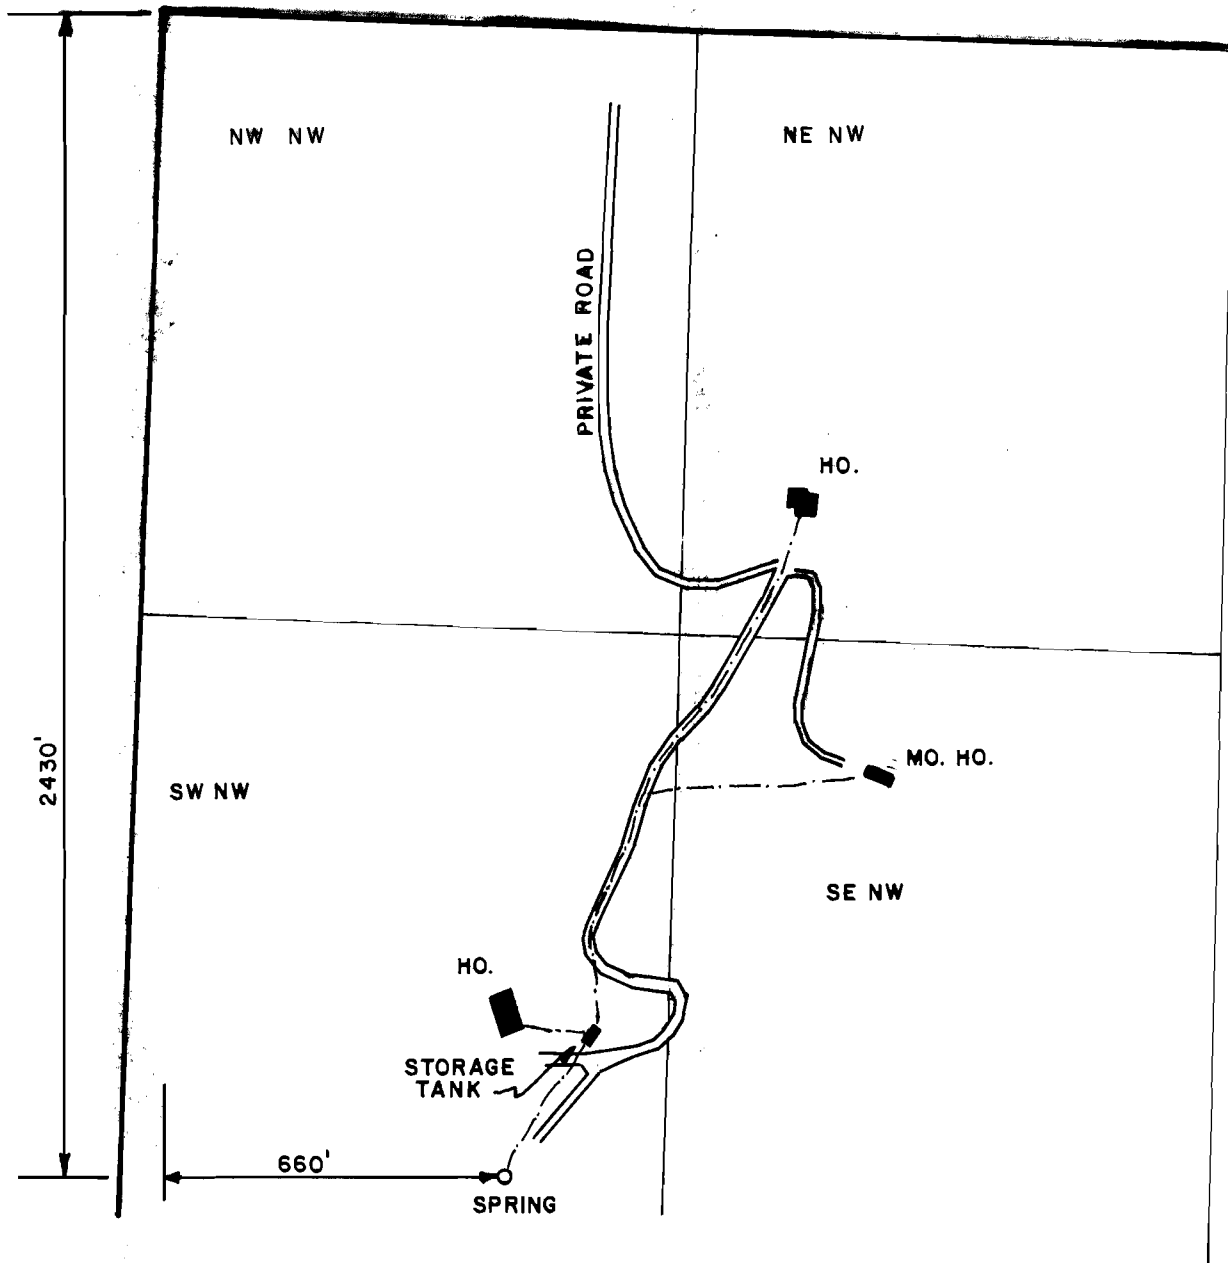

SCALE: 1" = 400'

FINAL PROOF SURVEY
UNDER

Application No. 56742... Permit No. 42482.....

IN NAME OF

ROBERT M. DEL CASTILLO

Surveyed MAY 11..... 1987., by J.M. SCHMORDE.