


T. 35 S., R. 7 W., W.M.

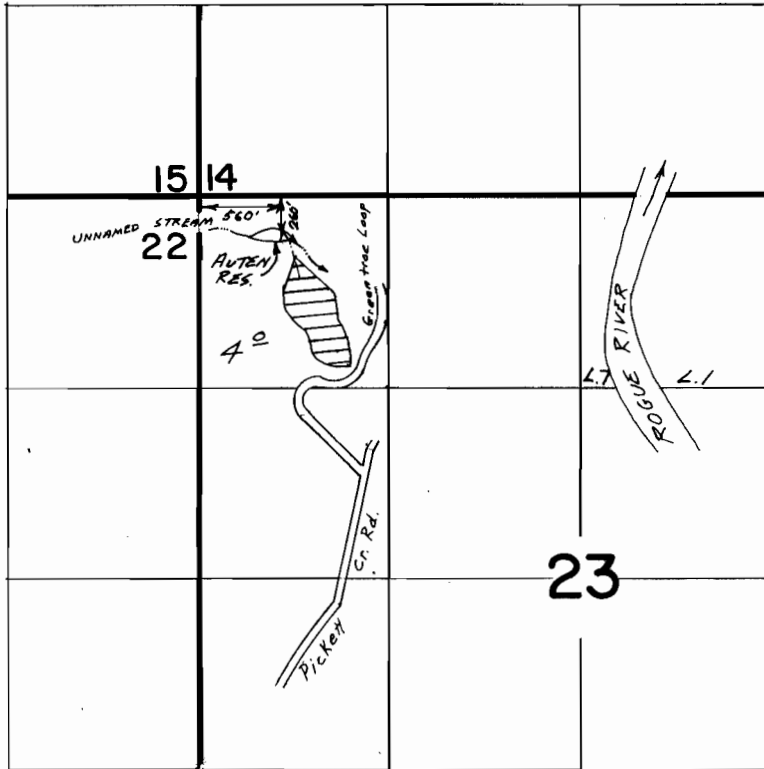

Scale : 1" = 1320'

FINAL PROOF SURVEY

UNDER

R-57128 R-7349

Application No. 57129 Permit No. 43109.....

IN NAME OF

Peter C. Sedlow.....and.....Lindi L. Leger.....

Surveyed Nov. 3, 1987, by B.S. JAMES.....