


T. 24 S., R. 12 W. W.M.

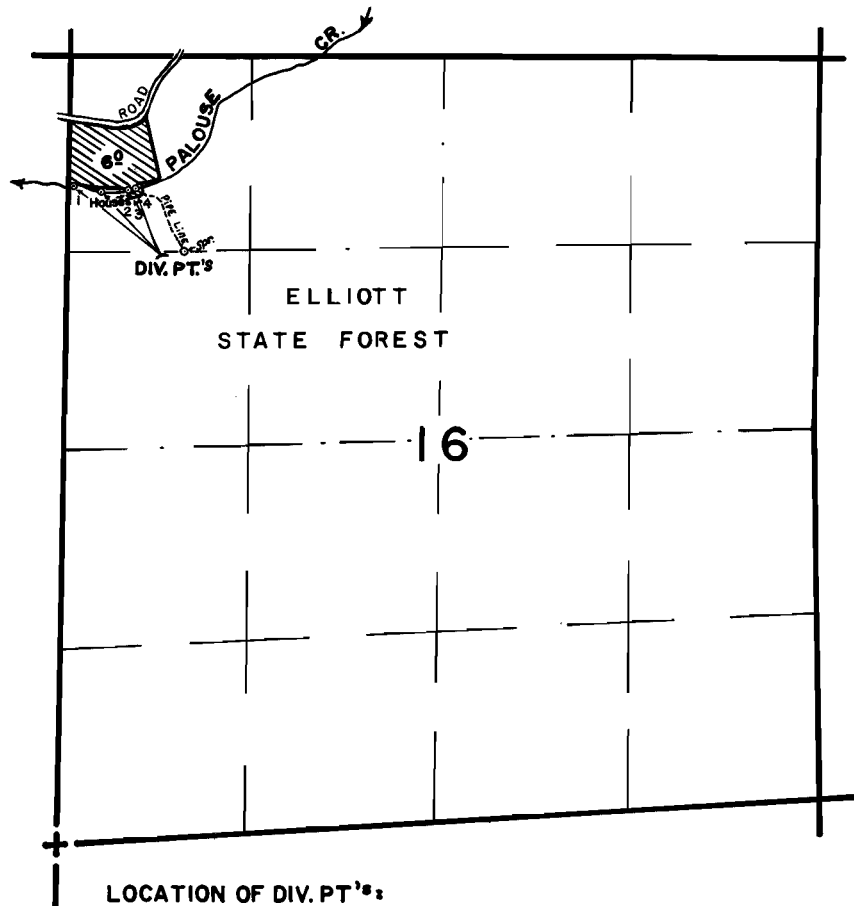

LOCATION OF DIV. PT.'s:

Spr. ("Creek A") - 800' DUE EAST OF $N\frac{1}{2}$ ON WEST LINE OF SEC 16
PALOUSE CR. - (ALL DIMENSIONS FROM $N\frac{1}{2}$ CORNER ON WEST LINE)

- 1) 480' North and 40' East
- 2) 415' North and 200' East
- 3) 460' North and 470' East
- 4) 488' North and 500' East

UPSTREAM



FINAL PROOF SURVEY UNDER

Application No. 61167 Permit No. 46472
IN NAME OF

ROBERT L. BURKLE

Surveyed Sept. 13 1990, by K. KEMP