

White Horse Spring

1/4 mile

Application No. 64061

Permit No. 48576

N A I I O N A L F O R E S T

Green Point Lower Res Camp Yallahs

M H N F

23 Kingsley Guard Sta

Green Point Upper Res

MT HOOD N F

DEAD POINT CREEK TRAIL

Dead Point

Sheep


Punchbowl Falls

Winata

W. Gaping I. Slab

BM 802

BM 806

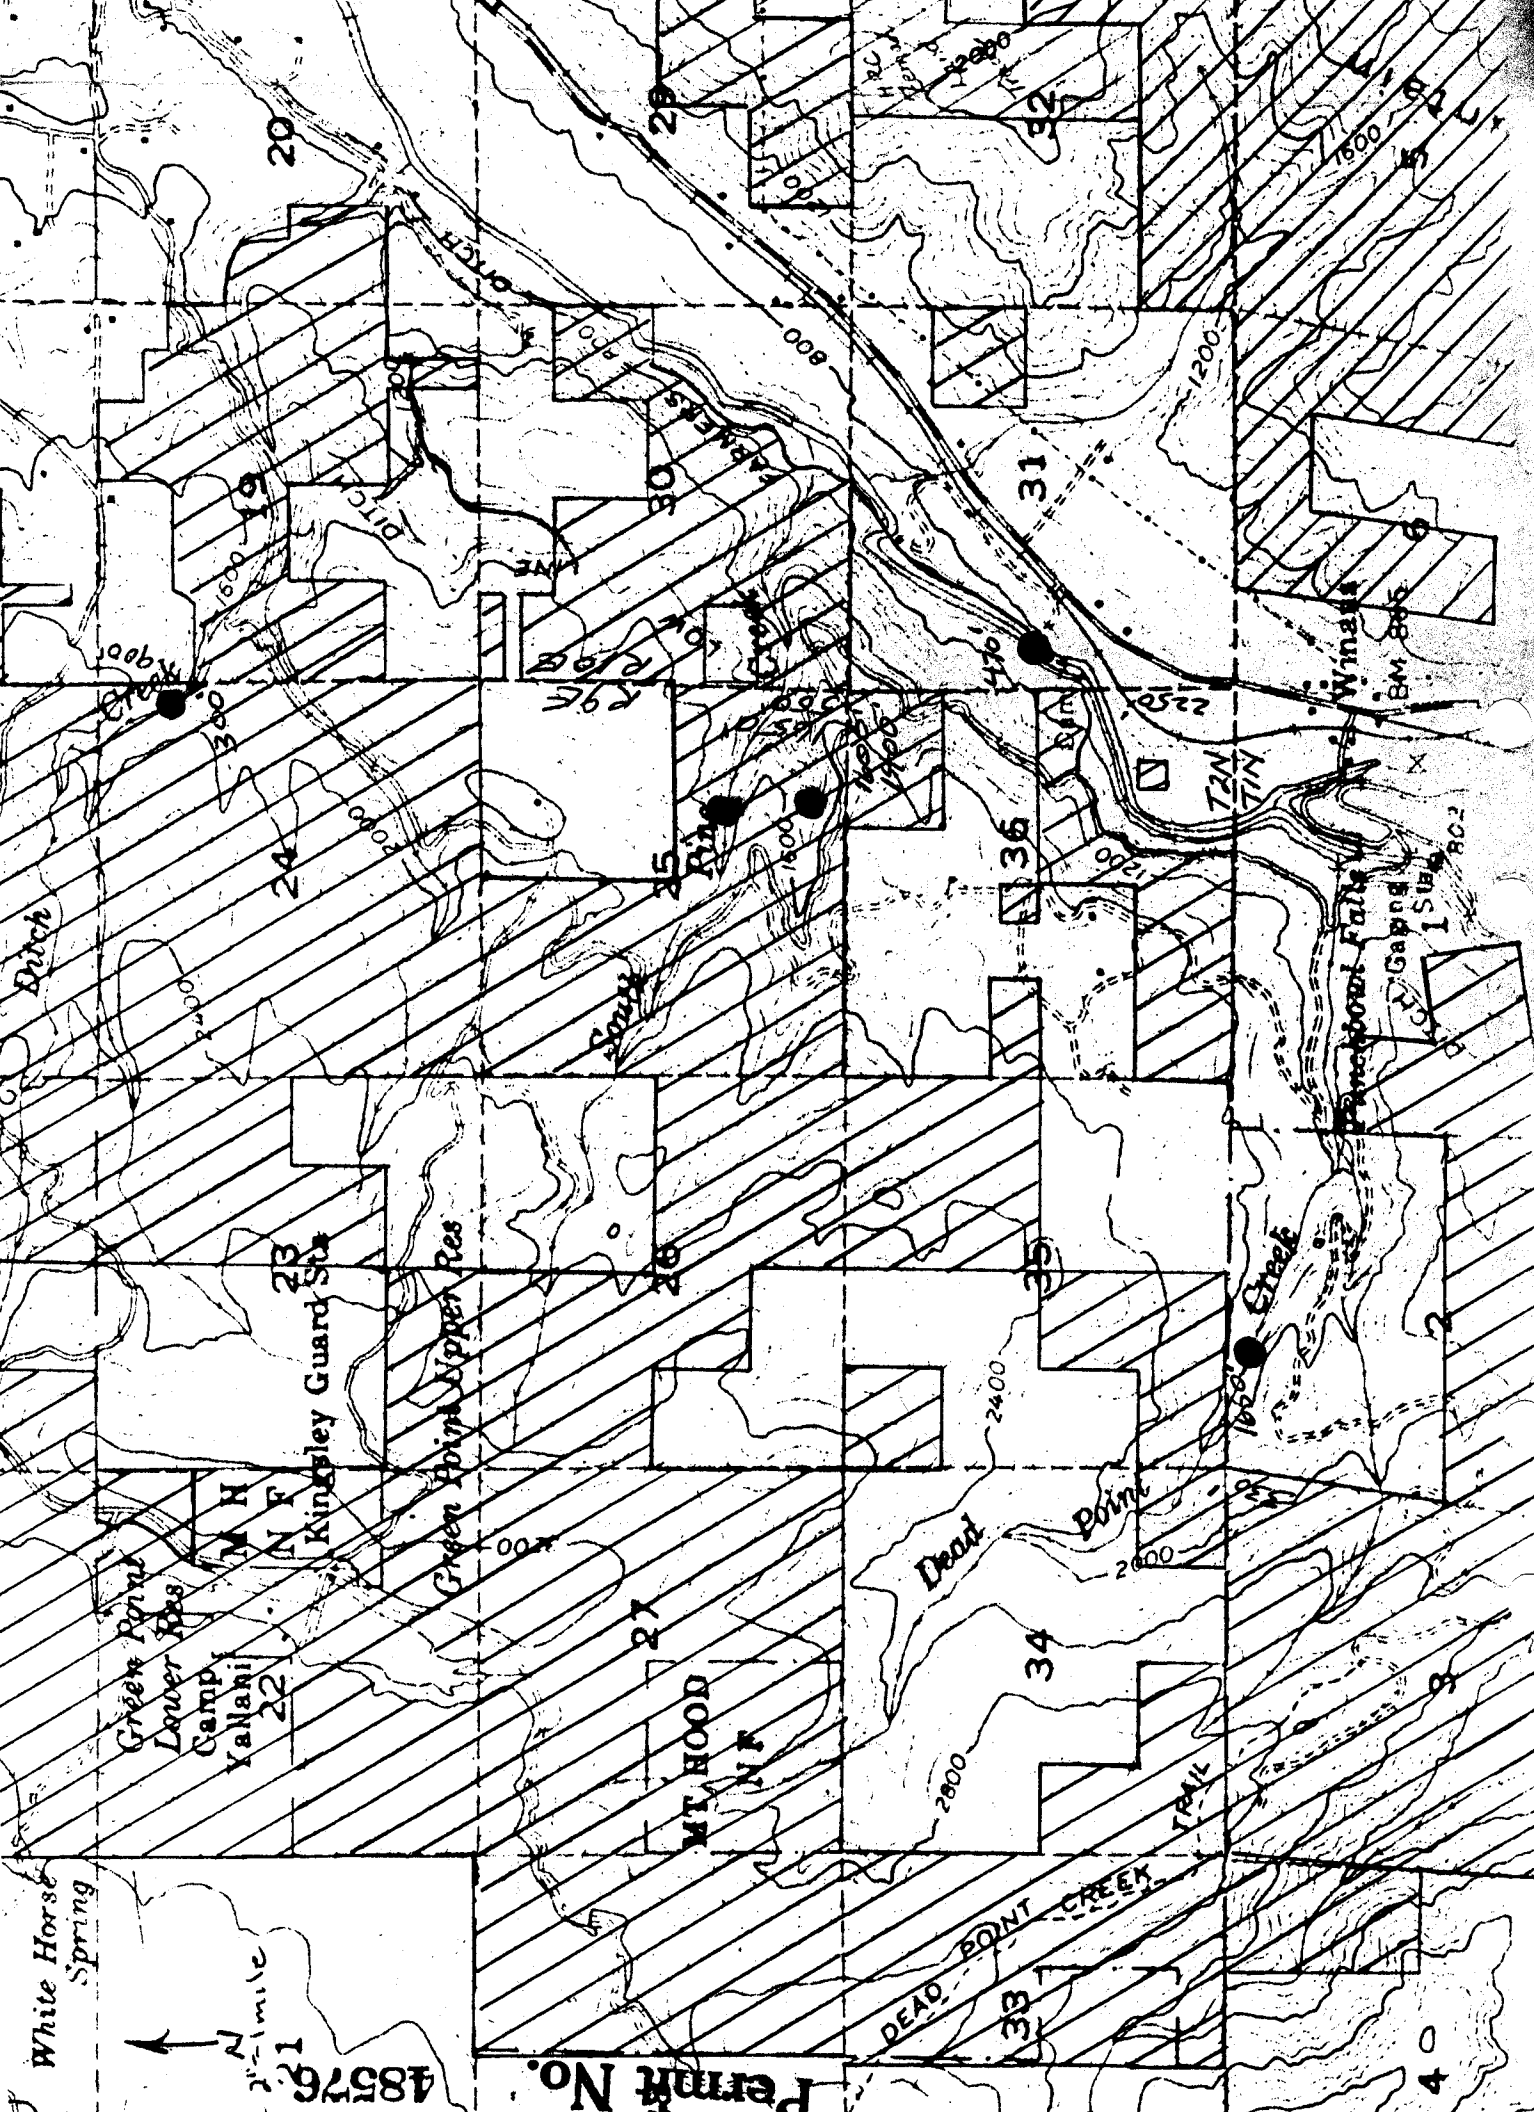

Application No. 64061

Permit No. 48576

N A I I O N A L F O R E S T