


**T.30S., R.4W., W.M.
SECTION 21**

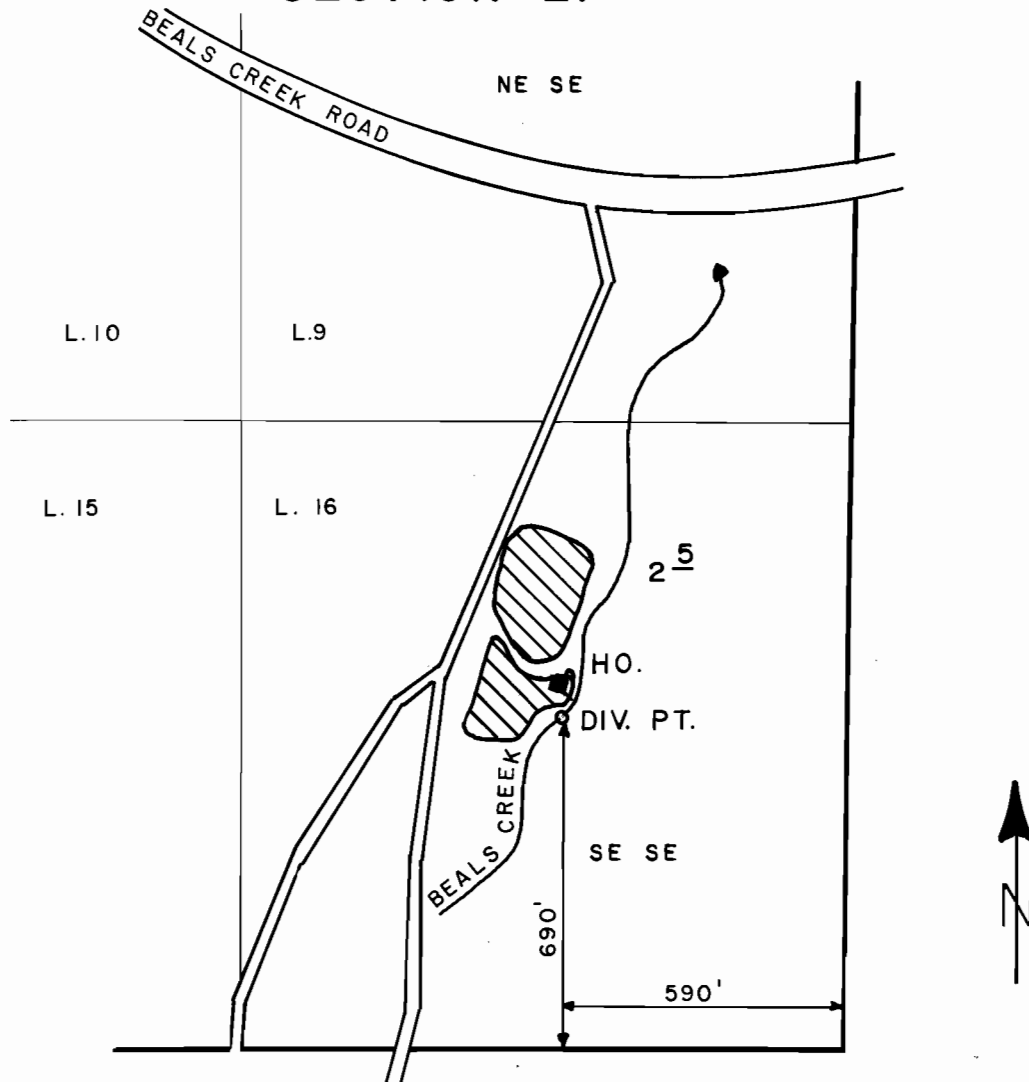

SCALE: 1" = 400'

**FINAL PROOF SURVEY
UNDER**

Application No. 65316 Permit No. 47924
IN NAME OF

EVERET & EVELYN ROWTON

Surveyed JUNE 18 1986, by J. M. SCHMORDE