


T.30S., R.4W., W.M.
SECTION 21

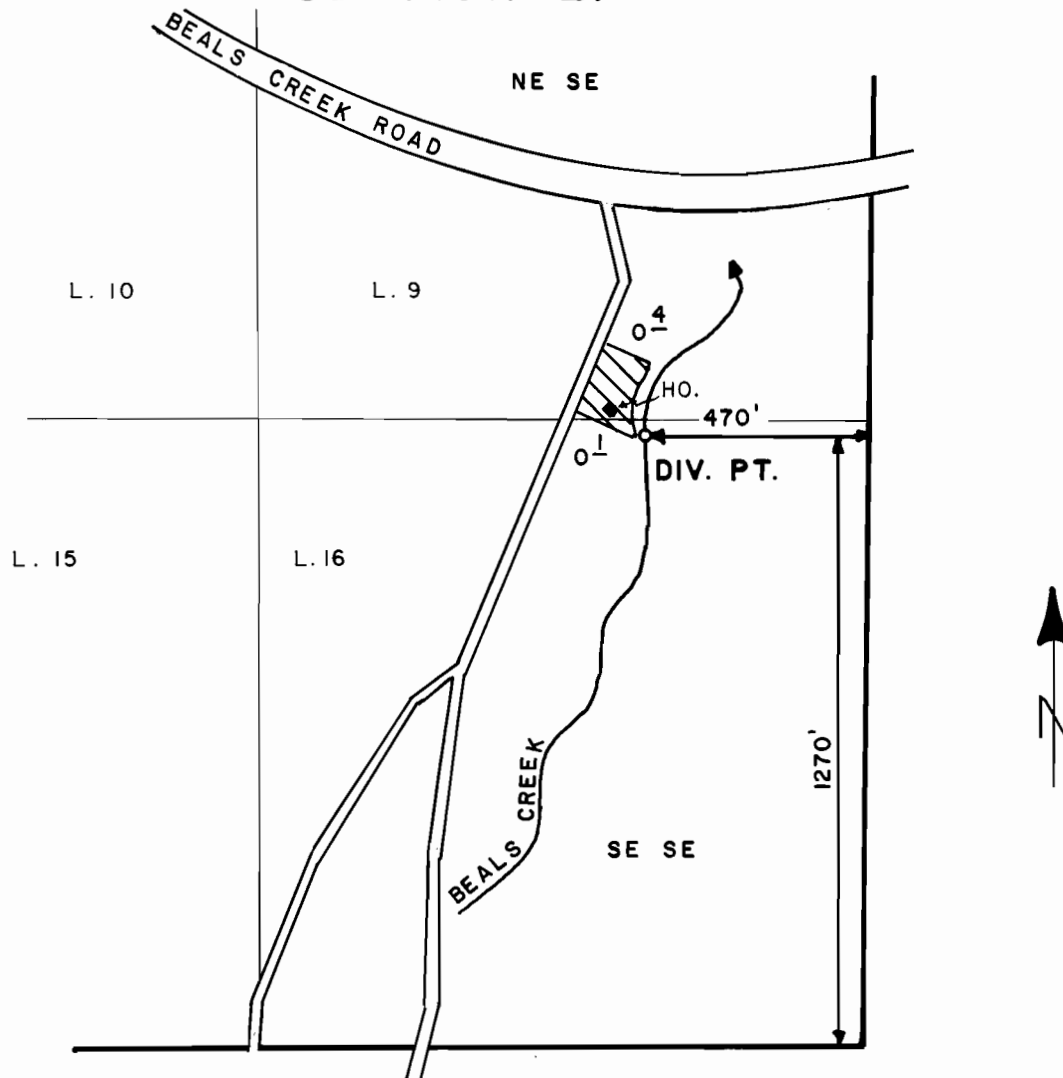

SCALE: 1" = 400'

FINAL PROOF SURVEY
UNDER

Application No. 65347 Permit No. 47941
IN NAME OF

CHARLES F. FERRELL

Surveyed JUNE 18 1986, by J. M. SCHMORDE