


T. 1 & 2 S. R. 25 E. W. M.

PERMIT N 48116
67270

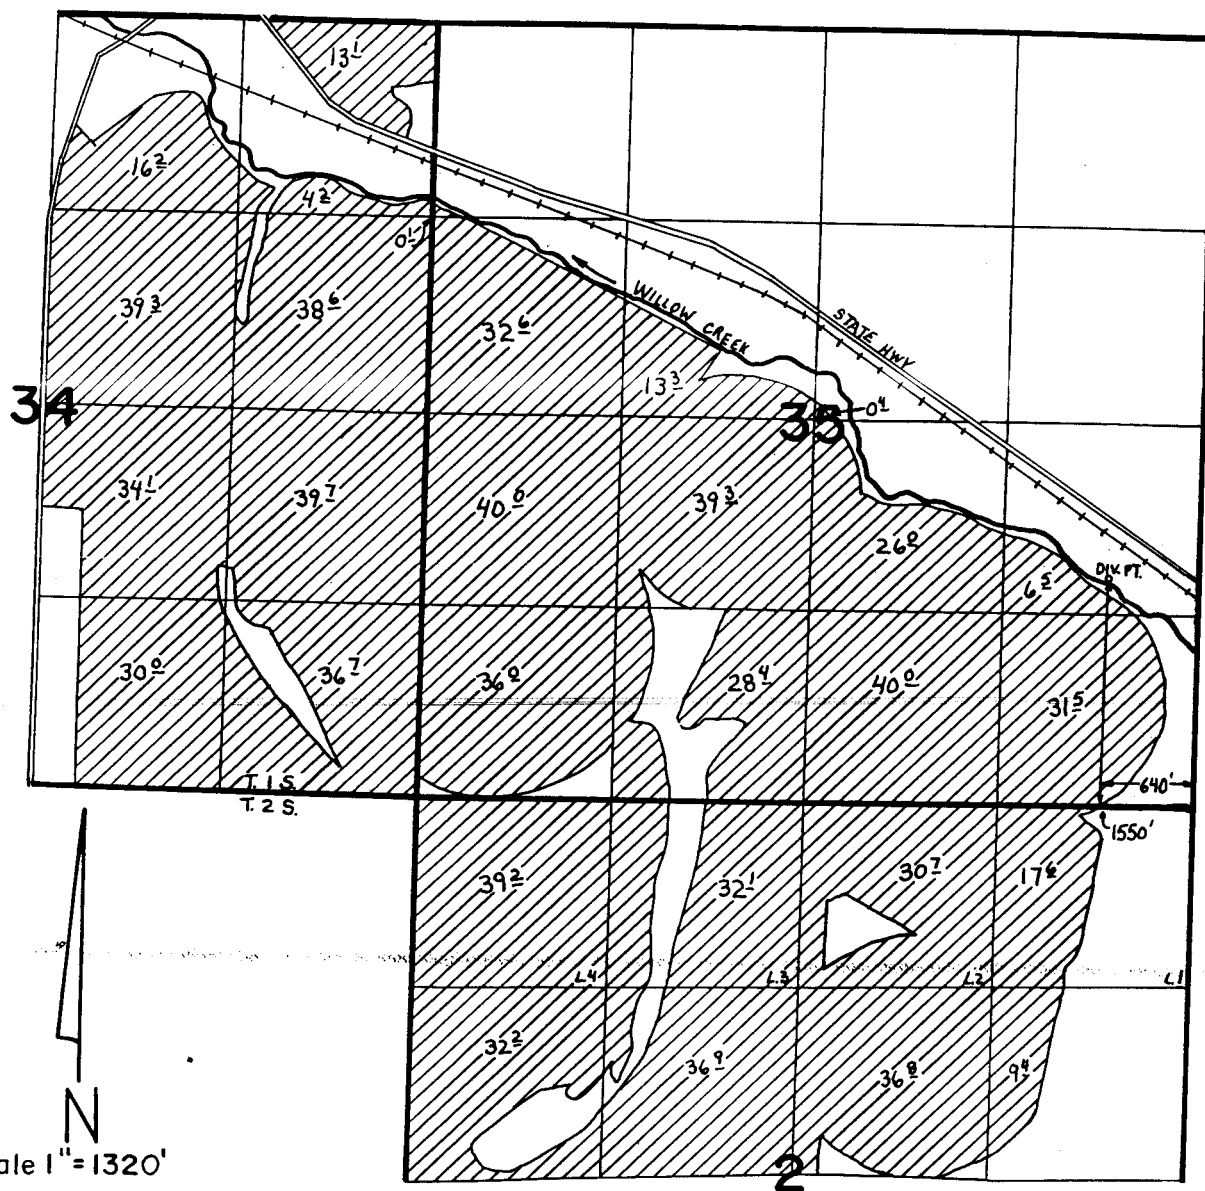

FINAL PROOF SURVEY
UNDER

Application No. 65503... Permit No. 48116.....
IN NAME OF

ELMER E. PADBERG

Surveyed Jan. 9, 1986, by V. Church