


T. 24 S., R. 12 W. W.M.

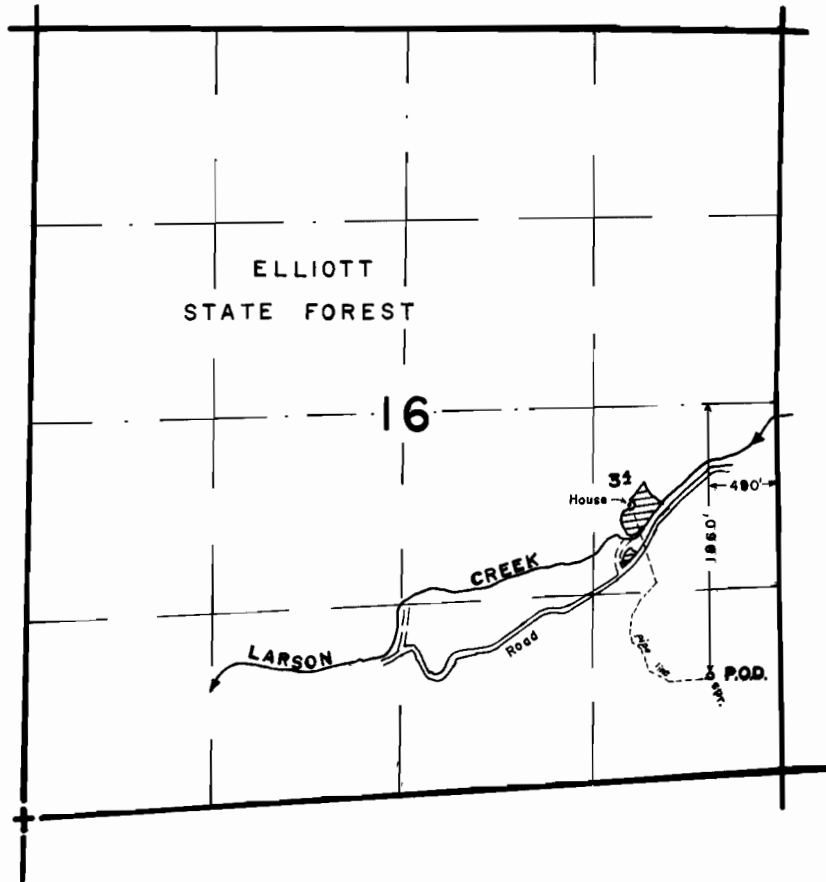

SCALE: 1" = 1320'

FINAL PROOF SURVEY UNDER

Application No. 68047 Permit No. 48956...
IN NAME OF

.....GORDON H. MENTZER.....

Surveyed Sept. 17, 1990, by J. Schmorde...

NOTE:
Location of P.O.D. taken from survey made
Aug. 27, 1984, by RICHARD J. HINTZ, P.L.S.