




1 INCH = 1320 FEET

FINAL PROOF SURVEY MAP
IN THE NAME OF LES SHEPHARD

SECTIONS 30 & 31, T24S, R5W, W.M.

APPLICATION 69665

PERMIT 50681

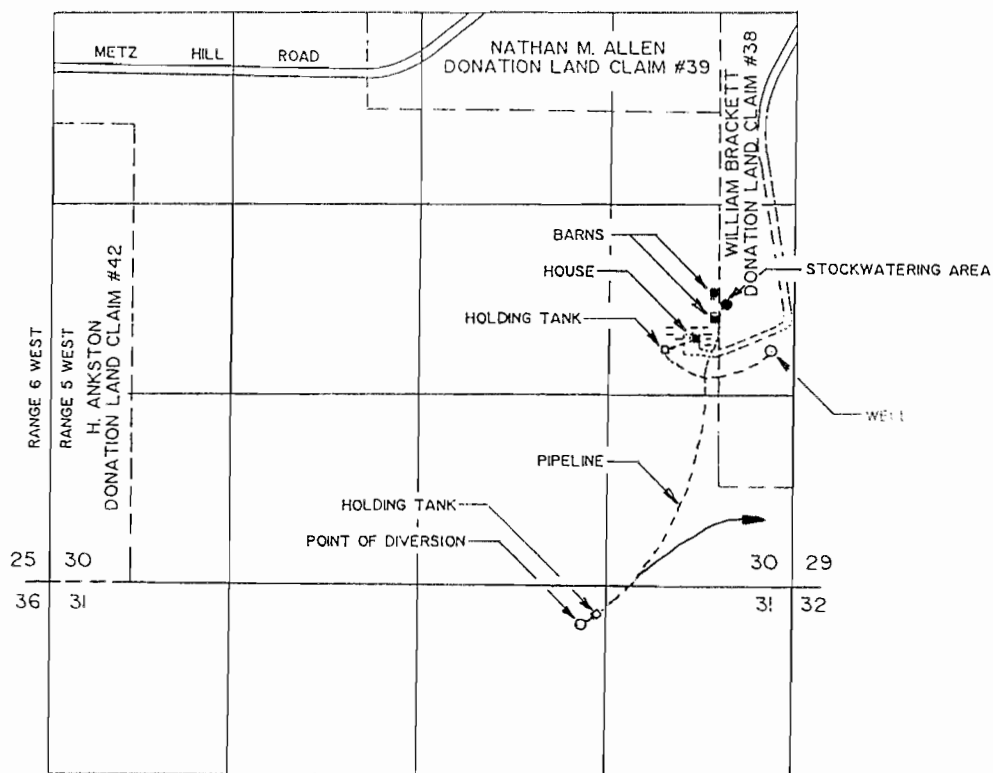

THE POINT OF DIVERSION IS LOCATED 294 FEET SOUTH
AND 1106 FEET EAST FROM THE NORTH 1/4 CORNER OF SECTION 31,
BEING WITHIN THE NW 1/4 OF THE NE 1/4 OF SECTION 31, TOWNSHIP
24 SOUTH, RANGE 5 WEST, W.M., DOUGLAS COUNTY.

THE PURPOSE OF THIS MAP IS TO IDENTIFY THE LOCATION OF
THE WATER RIGHT. IT IS NOT INTENDED TO PROVIDE INFOR-
MATION RELATIVE TO THE LOCATION OF PROPERTY OWNERSHIP
BOUNDARY LINES.

