
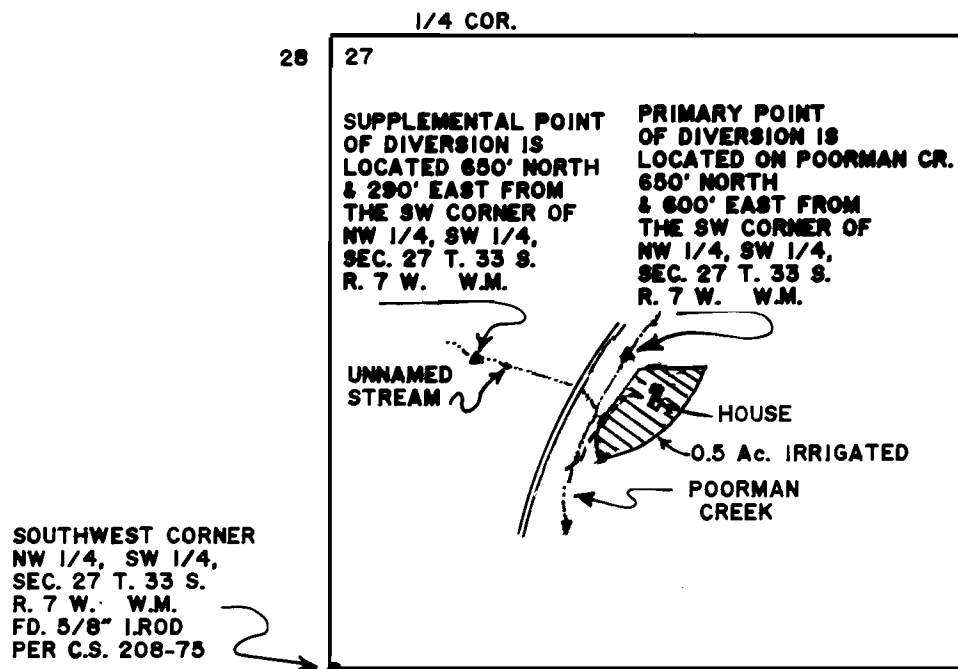


T. 33 S., R. 7 W. W.M.
NW 1/4, SW 1/4, SEC. 27

PREPARED BY:
JONATHAN C. SPERO W.R.E. 123
1002 KINCAID RD./P.O. BOX 16
WILLIAMS, OREGON 97544
PHONE (503) 846-6845

THIS MAP IS FOR THE PURPOSE OF
IDENTIFYING THE LOCATION OF THE
WATER RIGHT ONLY AND IS NOT
INTENDED TO PROVIDE LEGAL DIMEN-
SIONS OR LOCATIONS OF PROPERTY
OWNERSHIP LINES.

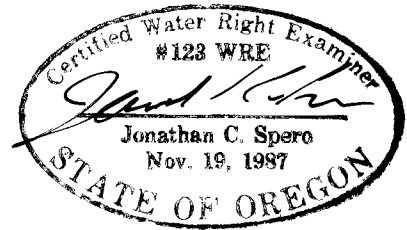

SCALE: 1" = 400'

FINAL PROOF SURVEY
UNDER

Application No. 69696 Permit No. 50423

IN NAME OF

EILEEN J. SEYLER

Surveyed 03 / 08, 19 91 by JONATHAN C. SPERO