

FINAL PROOF SURVEY MAP

IN THE NAME OF KEVIN C. KEHOE

SECTIONS 14, AND 15, T30S, R2W, W. M.

APPLICATION 70006

PERMIT 50834


RECEIVED

1990

WATER RESOURCES DEPT
SALEM, OREGON



1 INCH = 1320 FEET

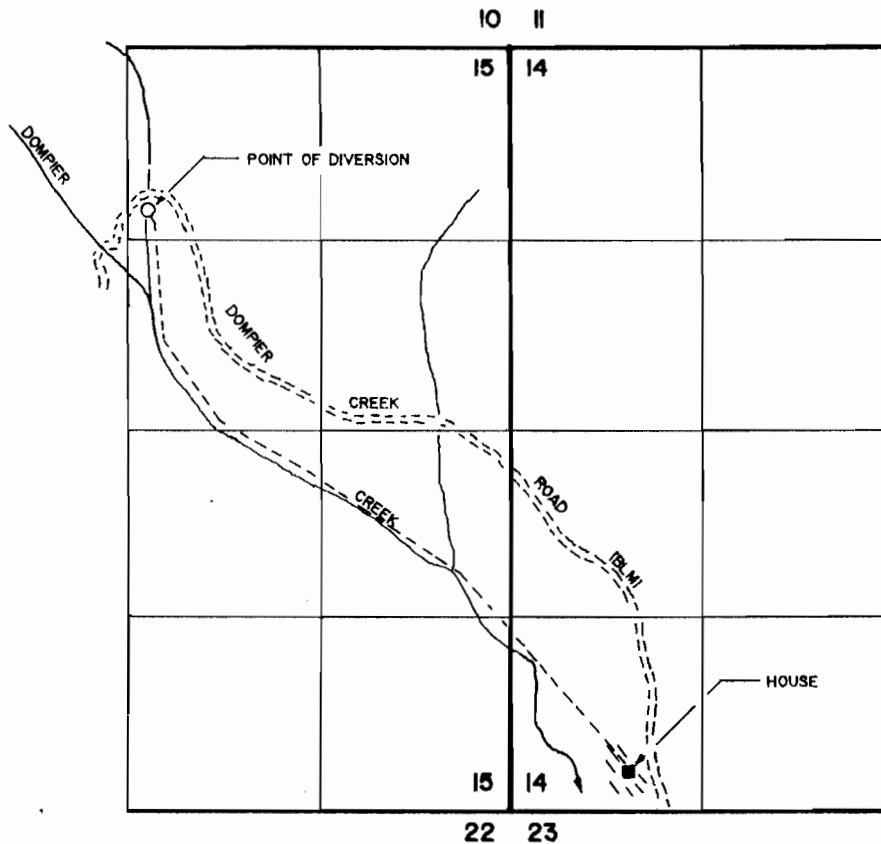

THE POINT OF DIVERSION IS LOCATED 1150 FEET SOUTH
AND 2480 FEET WEST FROM THE NE CORNER OF SECTION
15, BEING WITHIN THE NW 1/4 OF THE NE 1/4 OF SECTION 15,
TOWNSHIP 30 SOUTH, RANGE 2 WEST, W.M.

THE PURPOSE OF THIS MAP IS TO IDENTIFY THE LOCATION OF
THE WATER RIGHT. IT IS NOT INTENDED TO PROVIDE INFORMATION
RELATIVE TO THE LOCATION OF PROPERTY OWNERSHIP BOUNDARY
LINES.

