


# T.2N. R.10W. W.M.

THE PURPOSE OF THIS MAP IS TO IDENTIFY THE LOCATION OF THE WATER RIGHT. IT IS NOT INTENDED TO PROVIDE INFORMATION RELATIVE TO THE LOCATION OF PROPERTY OWNERSHIP BOUNDARY LINES.

DATE: 5/2/91  
BY: [Signature]  
TITLE: [Signature]

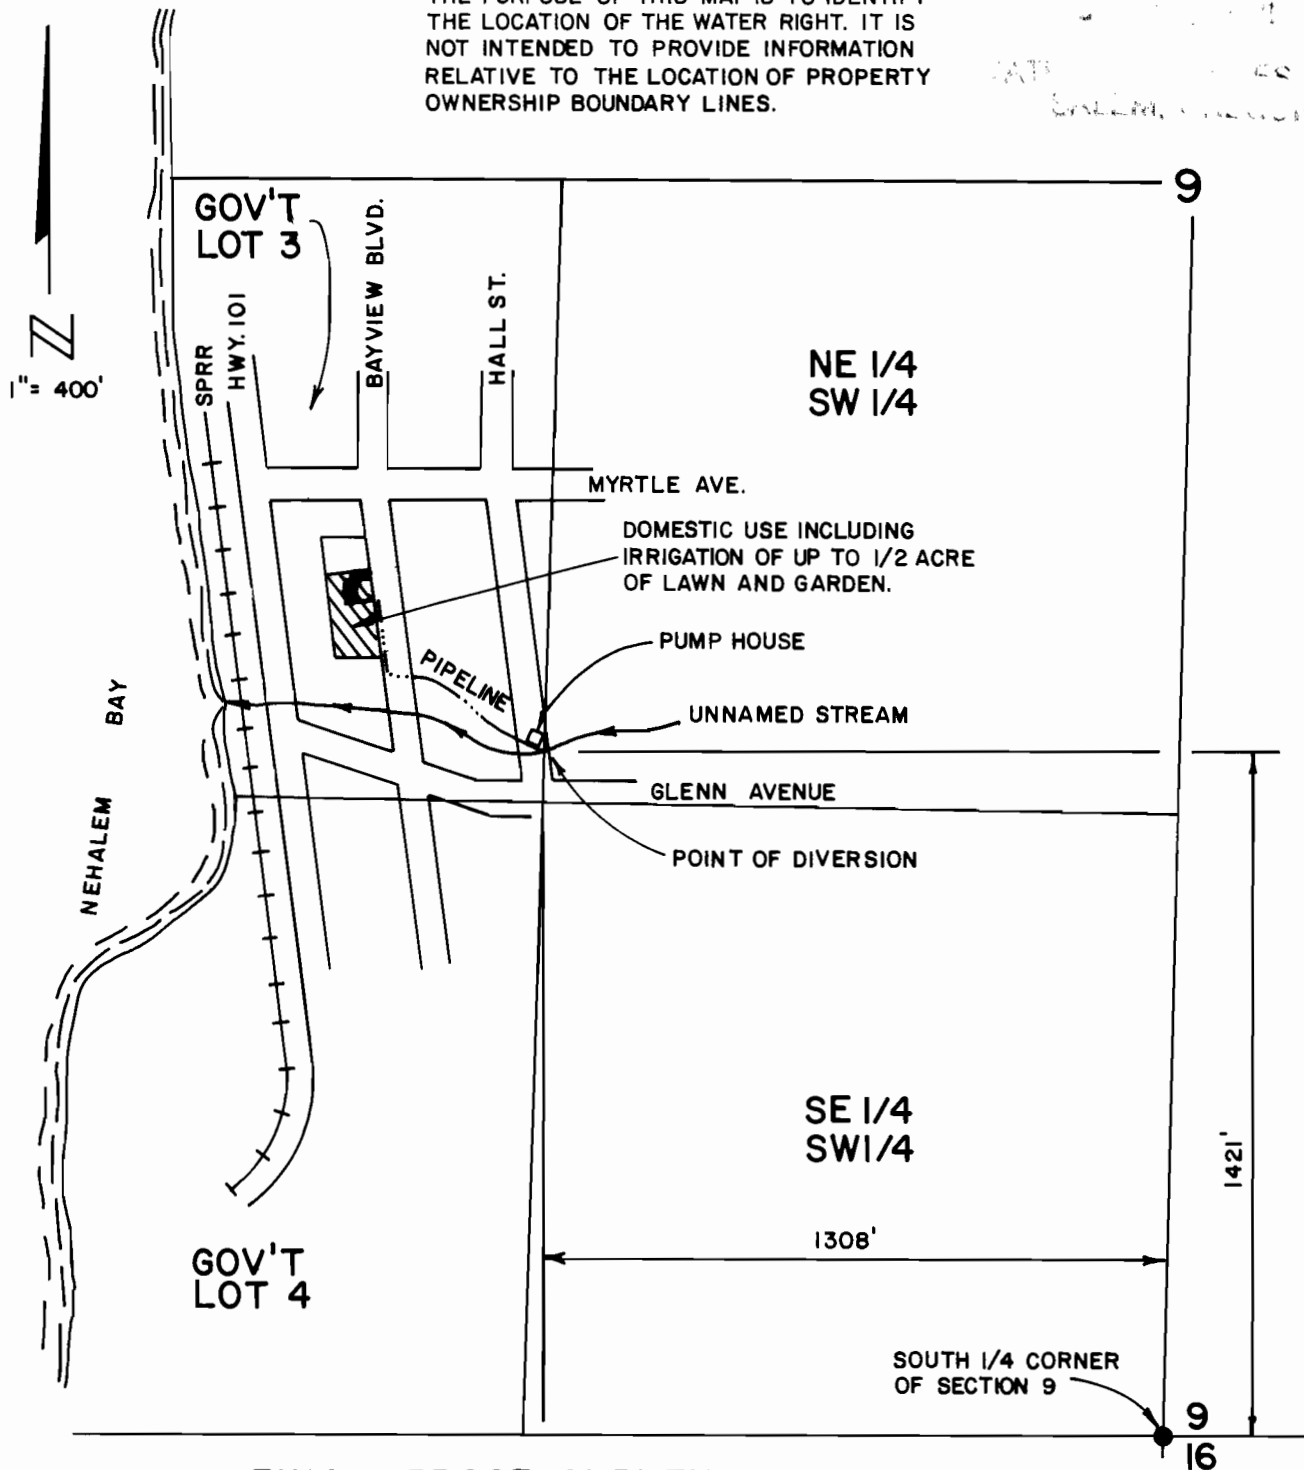

FINAL PROOF SURVEY  
UNDER  
APPLICATION NO. 70016 PERMIT NO. 50767  
IN NAME OF  
NORMAN E. JOHNSON  
SURVEYED MAY 2, 1991

