A FINAL PROOF MAP PREPARED FOR CLAIM OF BENEFICIAL USE & SITE REPORT UNDER APPLICATION PERMIT No. 70338

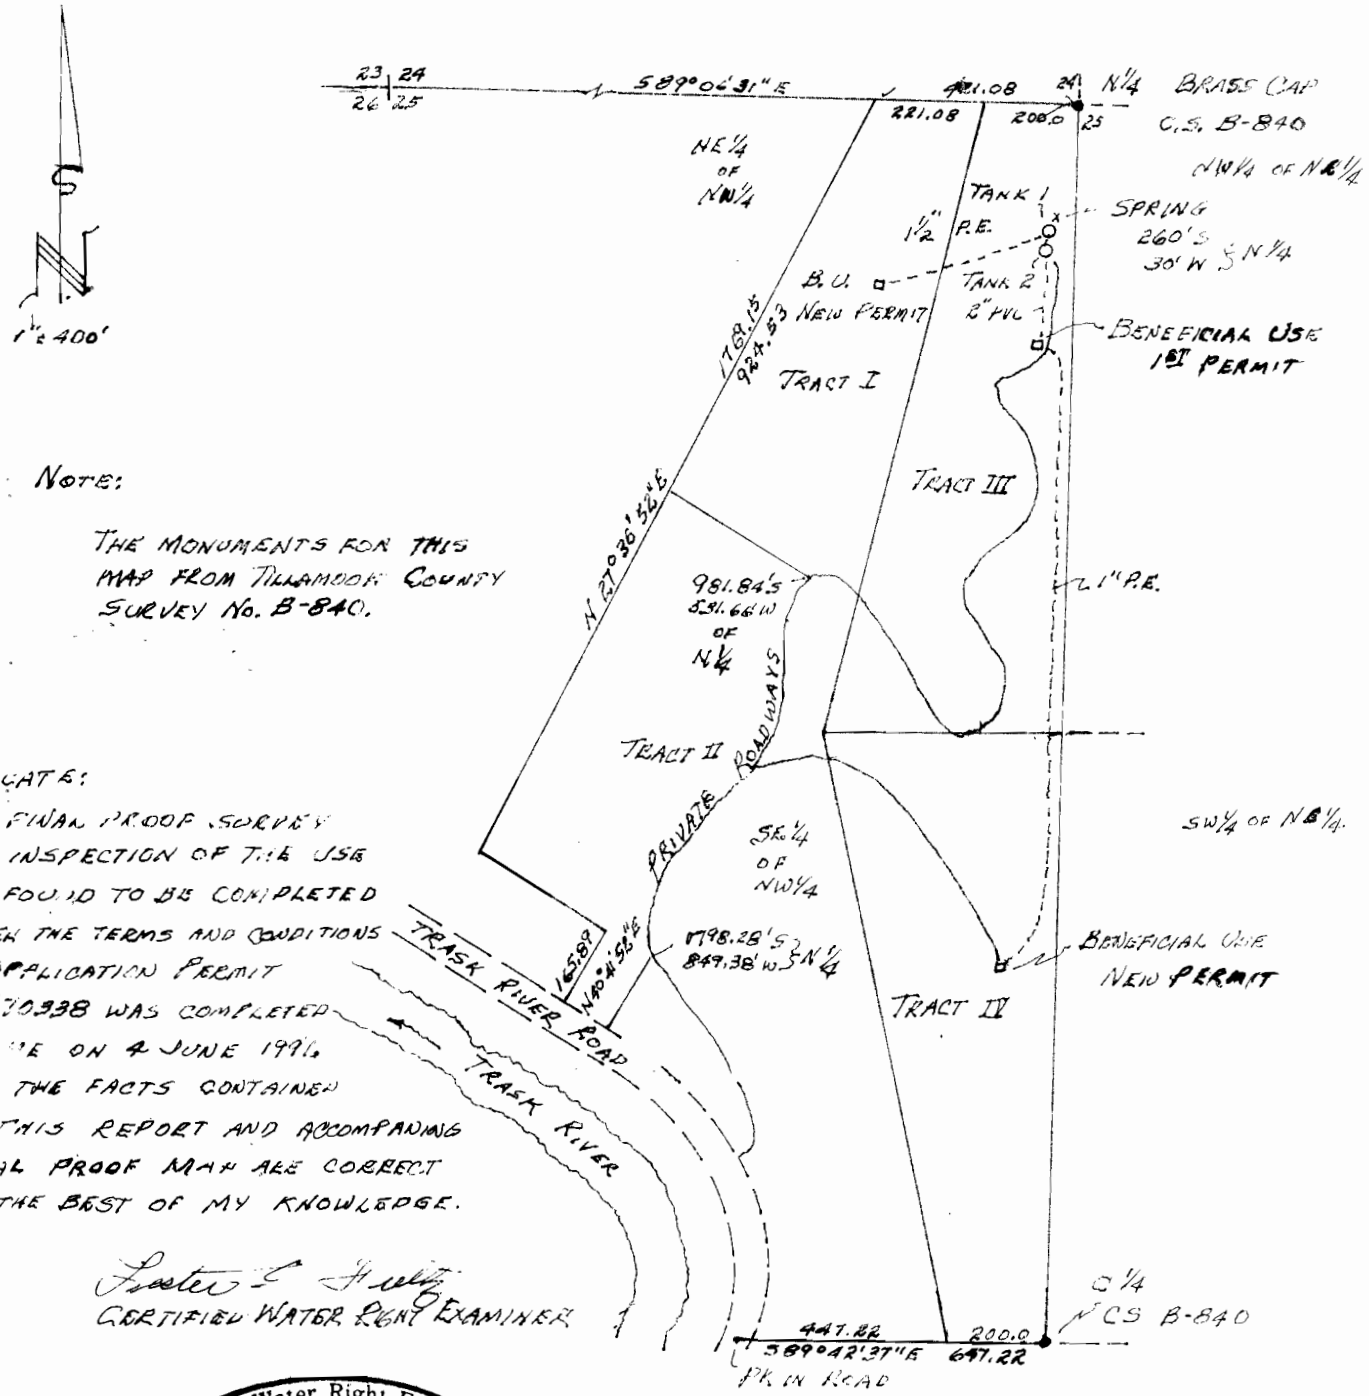

NOTE:

THE MONUMENTS FOR THIS MAP FROM TILLAMOOK COUNTY SURVEY No. B-840.

CERTIFICATE:

THE FINAL PROOF SURVEY AND INSPECTION OF THE USE AS FOUND TO BE COMPLETED UNDER THE TERMS AND CONDITIONS OF APPLICATION PERMIT No. 70338 WAS COMPLETED BY ME ON 4 JUNE 1991 AND THE FACTS CONTAINED IN THIS REPORT AND ACCOMPANYING FINAL PROOF MAP ARE CORRECT TO THE BEST OF MY KNOWLEDGE.

Lester E. Fritz
CERTIFIED WATER RIGHT EXAMINER

Certified Water Right Examiner
#051 WRE
Lester E. Fritz
Lester E. Fritz
Nov. 19, 1987
STATE OF OREGON

DRAWN - L.E. FRITZ
30 JUNE 1991