


NOTE: THIS MAP IS FOR THE LOCATION OF WATER RIGHTS AND IS NOT TO PROVIDE LEGAL DIMENSIONS OR LOCATION OF PROPERTY LINES.

T.17S., R.3W., W.M.

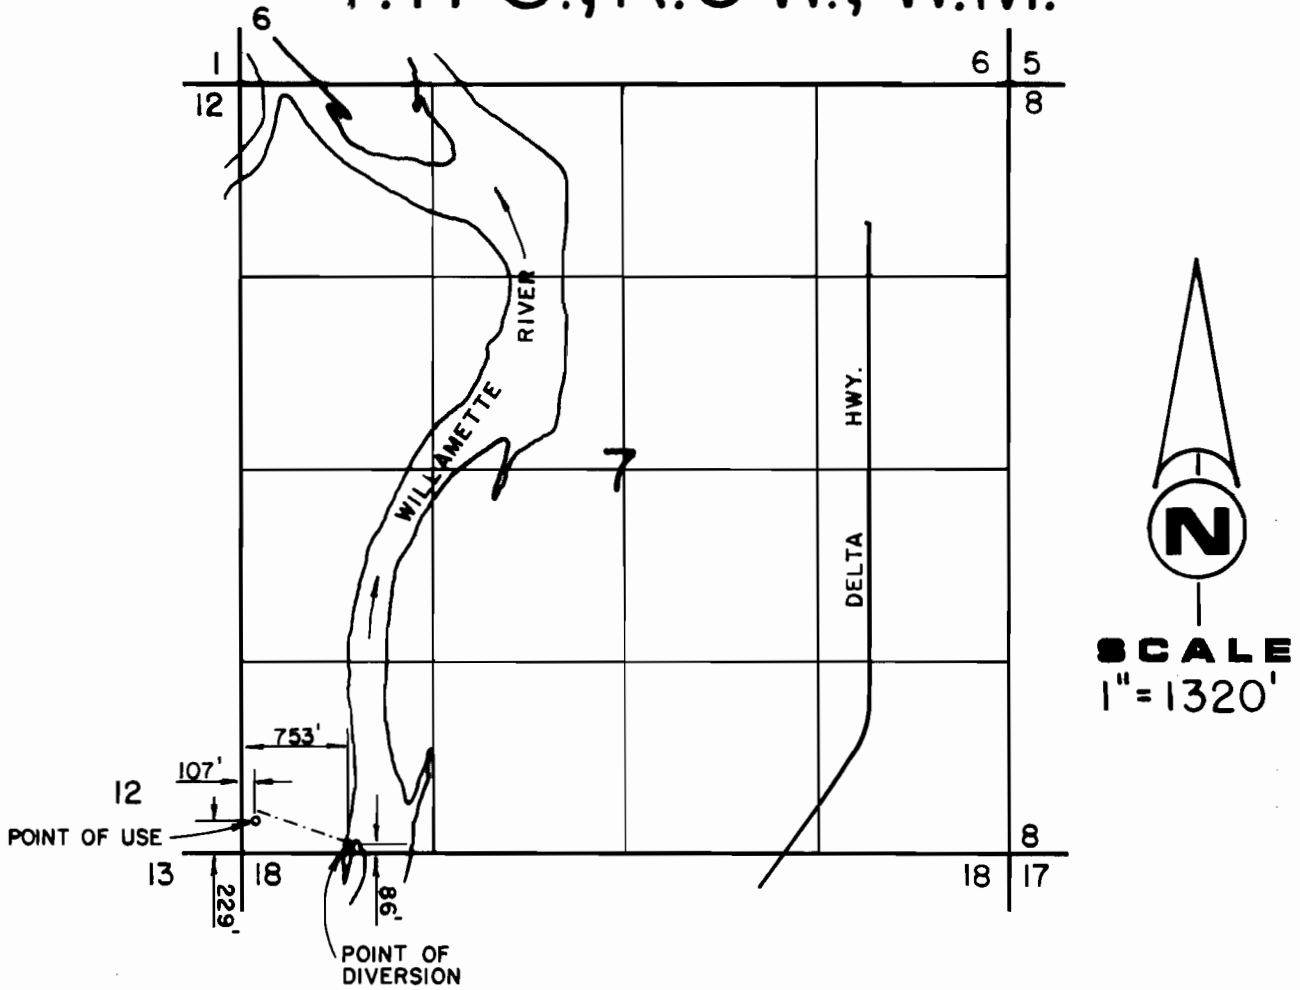

FINAL PROOF SURVEY

UNDER

Application No. 69317 Permit No. 50737
IN NAME OF

MORSE BROS., INC.

Surveyed SEPT. 5, 1990, by REVISED: 9/27/90
5/15/91

