
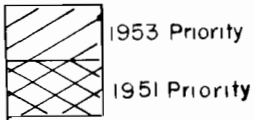


T.2N., R.3 W., W.M.

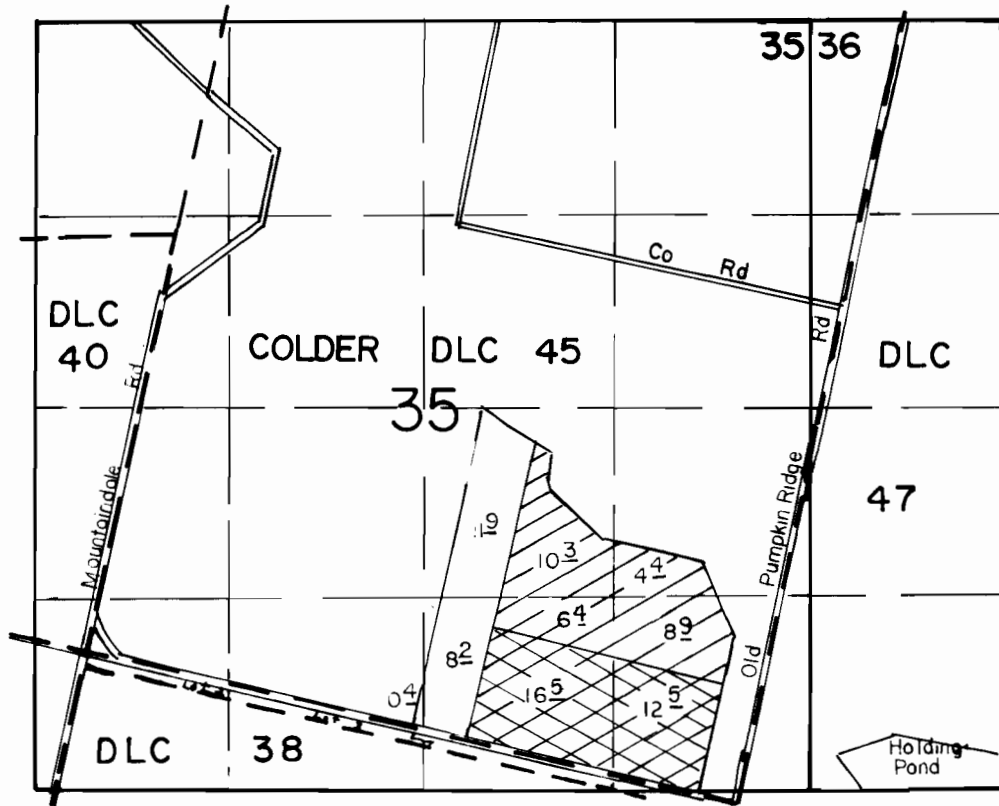

SCALE: 1"=1320'

FINAL PROOF SURVEY UNDER

TRANSFER 5906

Application No. Permit No.
IN NAME OF

..... **Dr. C A CHRISTENSEN**

Surveyed **JULY 10 1989**, by **T.M. WARREN**.....